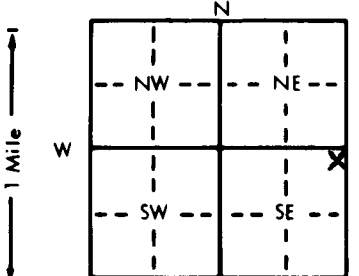


1 LOCATION OF WATER WELL: County: Franklin Fraction: NE 1/4 NE 1/4 SE 1/4 Section Number: 33 Township Number: T 15 S Range Number: R 19 E/W

Distance and direction from nearest town or city street address of well if located within city?
3 miles East and 1/2 mile South of Centropolis ks.

2 WATER WELL OWNER: Robert Bower
 RR#, St. Address, Box #: 4392 Louisiana Rd. Board of Agriculture, Division of Water Resources
 City, State, ZIP Code: OTTAWA Kansas 66067 Application Number:

3 LOCATE WELL'S LOCATION WITH AN "X" IN SECTION BOX:  4 DEPTH OF COMPLETED WELL: 128 ft. ELEVATION: _____ ft.
 Depth(s) Groundwater Encountered: 1 - 0 - ft. 2. _____ ft. 3. _____ ft.
 WELL'S STATIC WATER LEVEL: - 0 - ft. below land surface measured on mo/day/yr
 Pump test data: Well water was _____ ft. after _____ hours pumping _____ gpm
 Est. Yield: 0 gpm. Well water was _____ ft. after _____ hours pumping _____ gpm
 Bore Hole Diameter: 8 3/4 in. to 20 ft., and 7 7/8 in. to 128 ft.
 WELL WATER TO BE USED AS:
 1 Domestic 3 Feedlot 6 Oil field water supply 9 Dewatering 12 Other (Specify below)
 2 Irrigation 4 Industrial 7 Lawn and garden only 10 Monitoring well
 Was a chemical/bacteriological sample submitted to Department? Yes _____ No _____; If yes, mo/day/yr sample was submitted _____
 Water Well Disinfected? Yes _____ No _____

5 TYPE OF BLANK CASING USED:
 1 Steel 3 RMP (SR) 5 Wrought iron 8 Concrete tile CASING JOINTS: Glued _____ Clamped _____
 2 PVC 4 ABS 6 Asbestos-Cement 9 Other (specify below) None Welded _____
 7 Fiberglass Threaded _____
 Blank casing diameter: 0 in. to _____ ft., Dia _____ in. to _____ ft., Dia _____ in. to _____ ft.
 Casing height above land surface: 0 in., weight _____ lbs./ft. Wall thickness or gauge No. _____
 TYPE OF SCREEN OR PERFORATION MATERIAL:
 1 Steel 3 Stainless steel 5 Fiberglass 8 RMP (SR) 10 Asbestos-cement
 2 Brass 4 Galvanized steel 6 Concrete tile 9 ABS 11 Other (specify) NA
 12 None used (open hole)
 SCREEN OR PERFORATION OPENINGS ARE:
 1 Continuous slot 3 Mill slot 5 Gauzed wrapped 8 Saw cut 11 None (open hole)
 2 Louvered shutter 4 Key punched 6 Wire wrapped 9 Drilled holes NA
 7 Torch cut 10 Other (specify) _____
 SCREEN-PERFORATED INTERVALS: From NA ft. to NA ft., From _____ ft. to _____ ft.
 From _____ ft. to _____ ft., From _____ ft. to _____ ft.
 GRAVEL PACK INTERVALS: From _____ ft. to _____ ft., From _____ ft. to _____ ft.
 From _____ ft. to _____ ft., From _____ ft. to _____ ft.

6 GROUT MATERIAL: 1 Neat cement 2 Cement grout 3 Bentonite 4 Other _____
 Grout Intervals: From 128 ft. to 0 ft., From _____ ft. to _____ ft., From _____ ft. to _____ ft.
 What is the nearest source of possible contamination: None at the time
 1 Septic tank 4 Lateral lines 7 Pit privy 10 Livestock pens 14 Abandoned water well
 2 Sewer lines 5 Cess pool 8 Sewage lagoon 11 Fuel storage 15 Oil well/Gas well
 3 Watertight sewer lines 6 Seepage pit 9 Feedyard 12 Fertilizer storage 16 Other (specify below)
 13 Insecticide storage
 Direction from well? _____ How many feet? _____

| FROM | TO | LITHOLOGIC LOG | FROM | TO | PLUGGING INTERVALS |
|------|-----|---------------------|------|----|-----------------------|
| 0 | 6 | Soil + Clay | 128 | 0 | High Solids Bentonite |
| 6 | 12 | Yellow shale | | | |
| 12 | 13 | Coal | | | |
| 13 | 15 | Shale | | | |
| 15 | 18 | Lime | | | |
| 18 | 26 | Shale | | | |
| 26 | 28 | Lime | | | |
| 28 | 112 | Shale | | | |
| 112 | 122 | Sand- Silty + Limey | | | |
| 122 | 128 | Shale | | | |

7 CONTRACTOR'S OR LANDOWNER'S CERTIFICATION: This water well was ~~constructed~~ reconstructed, or (3) plugged under my jurisdiction and was completed on (mo/day/year) 10-5-94 and this record is true to the best of my knowledge and belief. Kansas Water Well Contractor's License No. 561 This Water Well Record was completed on (mo/day/yr) 10-9-94 under the business name of Evans Energy Dev. Inc. by (signature) [Signature]

OFFICE USE ONLY

T

R

EW

SEC.

1/4

1/4

1/4