WATER WELL RECORD Form WWC-5 KSA 82a-1212

1 LOCATION OF WATER WELL:	Fraction	Section Number	Township Number	Range Number
County: Dickinson	NW ¼ NE ¼ NE ¼	34	T 15 S	R 2 E/W*

Distance and direction from nearest town or city street address of well if located within city?

6 miles West of Hope, Ks on North side of town & 3/4 mile North & ¼ mile West

2 WATER WELL OWNER: Donald D. Phillips

RR#, St. Address, Box # : 980 Hwy 15

City, State, ZIP Code : Hope, Kansas 67451

Board of Agriculture, Division of Water Resources Application Number:

3 LOCATE WELL'S LOCATION WITH AN "X" IN SECTION BOX:

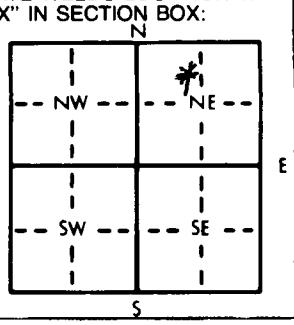

4 DEPTH OF COMPLETED WELL: 45 ft. ELEVATION:

Depth(s) Groundwater Encountered 1. 12-33 ft. 2. 33-42 ft. 3. ft.

WELL'S STATIC WATER LEVEL 4 ft. below land surface measured on mo/day/yr 12 / 15 / 98

Pump test data: Well water was ft. after hours pumping gpm

Est. Yield 10-80 gpm: Well water was ft. after hours pumping gpm

Bore Hole Diameter 5 in. to 45 ft., and in. to ft.

WELL WATER TO BE USED AS: 5 Public water supply 8 Air conditioning 11 Injection well; 1 Domestic 3 Feedlot 6 Oil field water supply 9 Dewatering 12 Other (Specify below); 2 Irrigation 4 Industrial 7 Lawn and garden only 10 Monitoring well Test Hole

Was a chemical/bacteriological sample submitted to Department? Yes No *; If yes, mo/day/yr sample was submitted

Water Well Disinfected? Yes * No

5 TYPE OF BLANK CASING USED: 5 Wrought iron 8 Concrete tile CASING JOINTS: Glued Clamped; 1 Steel 3 RMP (SR) 6 Asbestos-Cement 9 Other (specify below) NONE Welded; 2 PVC 4 ABS 7 Fiberglass Threaded

Blank casing diameter NONE in. to ft., Dia in. to ft., Dia in. to ft.

Casing height above land surface 0 in., weight lbs./ft. Wall thickness or gauge No.

TYPE OF SCREEN OR PERFORATION MATERIAL: 7 PVC 10 Asbestos-cement; 1 Steel 3 Stainless steel 5 Fiberglass 8 RMP (SR) 11 Other (specify) NA; 2 Brass 4 Galvanized steel 6 Concrete tile 9 ABS 12 None used (open hole)

SCREEN OR PERFORATION OPENINGS ARE: 5 Gauzed wrapped 8 Saw cut 11 None (open hole); 1 Continuous slot 3 Mill slot 6 Wire wrapped 9 Drilled holes; 2 Louvered shutter 4 Key punched 7 Torch cut 10 Other (specify) NA

SCREEN-PERFORATED INTERVALS: From 999 ft. to 999 ft., From ft. to ft.; From ft. to ft., From ft. to ft.

GRAVEL PACK INTERVALS: From ft. to ft., From ft. to ft.; From ft. to ft., From ft. to ft.

6 GROUT MATERIAL: 1 Neat cement 2 Cement grout 3 Bentonite 4 Other

Grout Intervals: From 1 ft. to 7 ft., From ft. to ft., From ft. to ft.

What is the nearest source of possible contamination: 10 Livestock pens 14 Abandoned water well; 1 Septic tank 4 Lateral lines 7 Pit privy 11 Fuel storage 15 Oil well/Gas well; 2 Sewer lines 5 Cess pool 8 Sewage lagoon 12 Fertilizer storage 16 Other (specify below); 3 Watertight sewer lines 6 Seepage pit 9 Feedyard 13 Insecticide storage

Direction from well? SOUTHWEST How many feet? ½ to 5/8 mile

FROM	TO	LITHOLOGIC LOG	FROM	TO	PLUGGING INTERVALS
0	12	DARK BLACK CLAY	0	1	TOP SOIL
12	13	GRAY CLAY & SOFT FINE SHALE	1	7	BENTONITE
13	42	SOFT & HARD GRAY SHALE	7	45	SAND PACKING
42	45	GRAY SHALE & GYPSUM ROCK			

7 CONTRACTOR'S OR LANDOWNER'S CERTIFICATION: This water well was (1) constructed, (2) reconstructed, or (3) plugged under my jurisdiction and was completed on (mo/day/year) 12 / 15 / 98 and this record is true to the best of my knowledge and belief. Kansas Water Well Contractor's License No. 397 This Water Well Record was completed on (mo/day/yr) 12 / 17 / 98 under the business name of CENTRAL KANSAS DRILLING by (signature) Harold D. Martin

INSTRUCTIONS: Use typewriter or ball point pen. *PLEASE PRESS FIRMLY* and *PRINT* clearly. Please fill in blanks, underline or circle the correct answers. Send top three copies to Kansas Department of Health and Environment, Bureau of Water, Topeka, Kansas 66620-0001. Telephone: 913-296-5545. Send one to WATER WELL OWNER and retain one for your records.

OFFICE USE ONLY T R E/W SEC. ¼ ¼ ¼