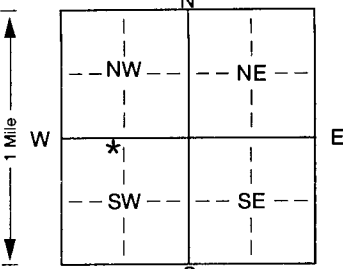


1 LOCATION OF WATER WELL: Fraction NE 1/4 NW 1/4 SW 1/4 Section Number 1 Township Number T 15 S Range Number R 2 (E/W)
 County: Dickinson
 Distance and direction from nearest town or city street address of well if located within city?
3 West & 1 1/2 South of Hope, KS.

2 WATER WELL OWNER: Chuck Haslouer
 RR#, St. Address, Box #: 1268 HWY 4 Hope, KS. Board of Agriculture, Division of Water Resources
 City, State, ZIP Code: Hope, KS. 67451 Application Number:

3 LOCATE WELL'S LOCATION WITH AN "X" IN SECTION BOX:

 4 DEPTH OF COMPLETED WELL... 55' ft. ELEVATION:
 Depth(s) Groundwater Encountered 1. ft. 2. ft. 3. ft.
 WELL'S STATIC WATER LEVEL 1-2 ft. below land surface measured on mo/day/yr 7/19/02
 Pump test data: Well water was ft. after hours pumping gpm
 Est. Yield 150+ gpm: Well water was ft. after hours pumping gpm
 Bore Hole Diameter... 19 in. to 20 ft., and... 13 1/2 in. to 55' ft.
 WELL WATER TO BE USED AS: 5 Public water supply 8 Air conditioning 11 Injection well
 1 Domestic 3 Feedlot 6 Oil field water supply 9 Dewatering 12 Other (Specify below)
 2 Irrigation 4 Industrial 7 Domestic (lawn & garden) 10 Monitoring well Pond Supply
 Was a chemical/bacteriological sample submitted to Department? Yes. No. *; If yes, mo/day/yr sample was submitted
 Water Well Disinfected? Yes * No

5 TYPE OF BLANK CASING USED: 5 Wrought iron 8 Concrete tile CASING JOINTS: Glued. * Clamped.
 1 Steel 3 RMP (SR) 6 Asbestos-Cement 9 Other (specify below) Welded
 2 PVC 4 ABS 7 Fiberglass Threaded
 Blank casing diameter... 12 in. to 35 ft., Dia. in. to ft., Dia. in. to ft.
 Casing height above land surface... 12 in., weight SCH 40 lbs./ft. Wall thickness or gauge No. 0.406
 TYPE OF SCREEN OR PERFORATION MATERIAL: 7 PVC 10 Asbestos-cement
 1 Steel 3 Stainless steel 5 Fiberglass 8 RMP (SR) 11 Other (specify)
 2 Brass 4 Galvanized steel 6 Concrete tile 9 ABS 12 None used (open hole)
 SCREEN OR PERFORATION OPENINGS ARE: 5 Gauzed wrapped 8 Saw cut 11 None (open hole)
 1 Continuous slot 3 Mill slot 6 Wire wrapped 9 Drilled holes
 2 Louvered shutter 4 Key punched 7 Torch cut 10 Other (specify)
 SCREEN-PERFORATED INTERVALS: From... 35 ft. to 55 ft., From ft. to ft.
 GRAVEL PACK INTERVALS: From... 20 ft. to 55 ft., From ft. to ft.

6 GROUT MATERIAL: 1 Neat cement 2 Cement grout 3 Bentonite 4 Other
 Grout intervals: From... 4 ft. to 20 ft., From ft. to ft., From ft. to ft.
 What is the nearest source of possible contamination:
 1 Septic tank 4 Lateral lines 7 Pit privy 10 Livestock pens 14 Abandoned water well
 2 Sewer lines 5 Cess pool 8 Sewage lagoon 11 Fuel storage 15 Oil well/Gas well
 3 Watertight sewer lines 6 Seepage pit 9 Feedyard 12 Fertilizer storage 16 Other (specify below)
 13 Insecticide storage
 Direction from well? None Present How many feet?

FROM	TO	LITHOLOGIC LOG	FROM	TO	PLUGGING INTERVALS
0	3	Topsoil			
3	36	Limestone & Yellow Shale			
36	39	Limestone (Cherty)			
39	49	Gray Shale			
49	55	Red Shale			

7 CONTRACTOR'S OR LANDOWNER'S CERTIFICATION: This water well was (1) constructed, (2) reconstructed, or (3) plugged under my jurisdiction and was completed on (mo/day/year) 7/19/02 and this record is true to the best of my knowledge and belief. Kansas
 Water Well Contractor's Licence No. 518 This Water Well Record was completed on (mo/day/yr) 7/21/02
 under the business name of Blue Valley Drilling by (signature) Tim Stank