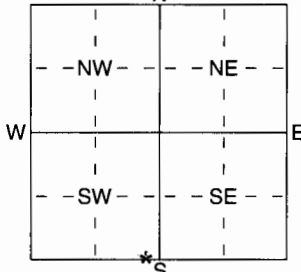


1 LOCATION OF WATER WELL: Fraction 33 1/4 33 1/4 33 1/4 Section Number 27 Township Number T 15 S Range Number R 2 E/W
 County: Dickinson

Distance and direction from nearest town or city street address of well if located within city?

14 miles South of Abilene, Ks on Hwy 15 to 800 Ave & 1 1/2 mile East

2 WATER WELL OWNER: Mike Ryff
 RR#, St. Address, Box # : 826 Hawk Rd Board of Agriculture, Division of Water Resources
 City, State, ZIP Code : Hope, Kansas 67451 Application Number:

3 LOCATE WELL'S LOCATION WITH AN "X" IN SECTION BOX:

 4 DEPTH OF COMPLETED WELL 5.0 ft. ELEVATION:
 Depth(s) Groundwater Encountered 1 3.0 ft. 2 ft. 3 ft.
 WELL'S STATIC WATER LEVEL 2.4 ft. below land surface measured on mo/day/yr 7 / 2 / 04
 Pump test data: Well water was ft. after hours pumping gpm
 Est. Yield 25.7 gpm: Well water was ft. after hours pumping gpm
 WELL WATER TO BE USED AS:
 1 Domestic 3 Feedlot 5 Public water supply 8 Air conditioning 11 Injection well
 2 Irrigation 4 Industrial 6 Oil field water supply 9 Dewatering 12 Other (Specify below)
 7 Domestic (lawn & garden) 10 Monitoring well
 Was a chemical/bacteriological sample submitted to Department? Yes No * ; If yes, mo/day/yrs sample was submitted
 Water Well Disinfected? Yes * No

5 TYPE OF BLANK CASING USED:
 1 Steel 3 RMP (SR) 5 Wrought iron 8 Concrete tile CASING JOINTS: Glued * Clamped
 2 PVC 4 ABS 6 Asbestos-Cement 9 Other (specify below) Welded
 7 Fiberglass Threaded
 Blank casing diameter 5 in. to 5.0 ft., Dia in. to ft., Dia in. to ft., Dia
 Casing height above land surface 1.4 in., weight 2.0 lbs./ft. Wall thickness or gauge No. 2.5
 TYPE OF SCREEN OR PERFORATION MATERIAL:
 1 Steel 3 Stainless Steel 5 Fiberglass 7 PVC 10 Asbestos-Cement
 2 Brass 4 Galvanized Steel 6 Concrete tile 8 RMP (SR) 11 Other (Specify)
 9 ABS 12 None used (open hole)
 SCREEN OR PERFORATION OPENINGS ARE:
 1 Continuous slot 3 Mill slot 5 Guazed wrapped 8 Saw cut 11 None (open hole)
 2 Louvered shutter 4 Key punched 6 Wire wrapped 9 Drilled holes
 7 Torch cut 10 Other (specify)
 SCREEN-PERFORATED INTERVALS: From 3.0 ft. to 5.0 ft., From ft. to ft.
 GRAVEL PACK INTERVALS: From 2.2 ft. to 5.0 ft., From ft. to ft.

6 GROUT MATERIAL: 1 Neat cement 2 Cement grout 3 Bentonite 4 Other
 Grout Intervals: From 0 ft. to 2.2 ft., From ft. to ft., From ft. to ft.
 What is the nearest source of possible contamination:
 1 Septic tank 4 Lateral lines 7 Pit privy 10 Livestock pens 14 Abandoned water well
 2 Sewer lines 5 Cess pool 8 Sewage lagoon 11 Fuel storage 15 Oil well/Gas well
 3 Watertight sewer lines 6 Seepage pit 9 Feedyard 12 Fertilizer storage 16 Other (specify below)
 13 Insecticide storage
 Direction from well? EAST APPROX How many feet? 200

FROM	TO	LITHOLOGIC LOG	FROM	TO	PLUGGING INTERVALS
0	1	DARK TOP SOIL			
1	3	GRAY LITE COLOR CLAY & SHALE			
3	30	LITE COLOR CLAY			
30	37	LITE COLOR SOFT SHALE			
37	38	LITE COLOR LIMESTONE			
38	50	BROWN & LITE GRAY CLAY			

7 CONTRACTOR'S OR LANDOWNER'S CERTIFICATION: This water well was (1) constructed, (2) reconstructed, or (3) plugged under my jurisdiction and was completed on (mo/day/year) 7 / 2 / 04 and this record is true to the best of my knowledge and belief. Kansas
 Water Well Contractor's Licence No 397 This Water Well Record was completed on (mo/day/yr) 7 / 6 / 04
 under the business name of CENTRAL KANSAS DRILLING by (signature) Harold R. Martin

INSTRUCTIONS: Use typewriter or ball point pen. PLEASE PRESS FIRMLY and PRINT clearly. Please fill in blanks, underline or circle the correct answers. Send top three copies to Kansas Department of Health and Environment, Bureau of Water, Geology Section, 1000 SW Jackson St., Suite 420, Topeka, Kansas 66612-1367. Telephone 785-296-5522. Send one to WATER WELL OWNER and retain one for your records. Fee of \$5.00 for each constructed well.