

WATER WELL RECORD Form WWC-5

Original Record Correction Change in Well Use


Division of Water Resources App. No.

Well ID

Well ID

1 LOCATION OF WATER WELL: County: Dickinson, Fraction: SW SE SE, Section Number: 16, Township Number: T 15 S, Range Number: R 2 E W

2 WELL OWNER: Last Name: Estes, First: Mike, Street or Rural Address where well is located: 981 - 1000 Ave, City: Hope, State: Ks, ZIP: 67451

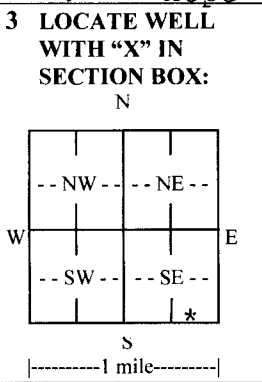

4 DEPTH OF COMPLETED WELL: 7.3 ft. Depth(s) Groundwater Encountered: 1) 4.3 ft., 2) ... ft., 3) ... ft., or 4) Dry Well. WELL'S STATIC WATER LEVEL: 3.2 ft. below land surface, measured on (mo-day-yr) 5/5/14.

5 Latitude: ... (decimal degrees) Longitude: ... (decimal degrees) Datum: WGS 84 NAD 83 NAD 27 Source for Latitude/Longitude: GPS (unit make/model: ... (WAAS enabled? Yes No) Land Survey Topographic Map Online Mapper

6 Elevation: ... ft. Ground Level TOC Source: Land Survey GPS Topographic Map Other

7 WELL WATER TO BE USED AS: 1. Domestic: Household Lawn & Garden Livestock Irrigation Feedlot Industrial 5. Public Water Supply: well ID 6. Dewatering: how many wells? 7. Aquifer Recharge: well ID 8. Monitoring: well ID 9. Environmental Remediation: well ID 10. Oil Field Water Supply: lease 11. Test Hole: well ID 12. Geothermal: how many bores? 13. Other (specify):

Was a chemical/bacteriological sample submitted to KDHE? Yes No If yes, date sample was submitted: Water well disinfected? Yes No

8 TYPE OF CASING USED: Steel PVC Other CASING JOINTS: Glued Clamped Welded Threaded Casing diameter: 5 in. to 7.3 ft., Diameter in. to ft., Diameter in. to ft. Casing height above land surface: 1.6 in. Weight: 2.0 lbs./ft. Wall thickness or gauge No.: 2.5 GRAVEL PACK INTERVALS: From 2.3 ft. to 7.3 ft., From ft. to ft., From ft. to ft.

9 GROUT MATERIAL: Neat cement Cement grout Bentonite Other Grout Intervals: From 3 ft. to 2.3 ft., From ft. to ft., From ft. to ft. Nearest source of possible contamination: Septic Tank Sewer Lines Watertight Sewer Lines Other (Specify) Lateral Lines Cess Pool Seepage Pit Pit Privy Sewage Lagoon Feedyard Livestock Pens Fuel Storage Fertilizer Storage Insecticide Storage Abandoned Water Well Oil Well/Gas Well

Table with columns: 10 FROM, TO, LITHOLOGIC LOG, FROM, TO, LITHO. LOG (cont.) or PLUGGING INTERVALS. Rows include: 0-3 DARK CLAY, 3-8 BROWN CLAY, 8-21 TAN CLAY, 21-44 LIGHT COLOR SHALE, 44-45 GRAY SHALE, 45-50 LIGHT COLOR SHALE, 50-73 GRAY SHALE.

11 CONTRACTOR'S OR LANDOWNER'S CERTIFICATION: This water well was constructed, reconstructed, or plugged under my jurisdiction and was completed on (mo-day-year) 5/5/14 and this record is true to the best of my knowledge and belief. Kansas Water Well Contractor's License No. 397 This Water Well Record was completed on (mo-day-year) 5/14/14 under the business name of CENTRAL KANSAS DRILLING