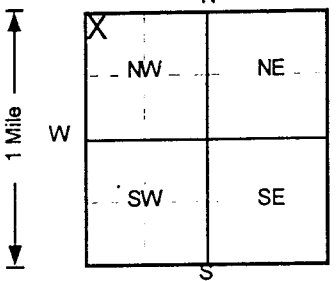


1 LOCATION OF WATER WELL: Fraction NW ¼ NW ¼ NW ¼ Section Number 3 Township Number T 15 S Range Number R 20 **EW**

Distance and direction from nearest town or city street address of well if located within city?
Fifth and Ames, Baldwin, Kansas

2 WATER WELL OWNER: **J & L Service**
 RR#, St Address, Box # : **Box 93** Board of Agriculture, Division of Water Resources
 City, State, ZIP Code : **Baldwin, Kansas 66066** Application Number:

3 LOCATE WELL'S LOCATION WITH AN "X" IN SECTION BOX:

 4 DEPTH OF COMPLETED WELL **48** ft ELEVATION: **1051.96**
 Depth(s) Groundwater Encountered 1. **21.54** ft 2. ft 3. ft
 WELL'S STATIC WATER LEVEL **21.51** ft below land surface measured on **mo/day/yr** **7/10/97**
 Pump test data: Well water was **NA** ft after hours pumping gpm
 Est Yield **NA** gpm: Well water was ft after hours pumping gpm
 Bore Hole Diameter **8** in. to **48** ft, and in. to ft
 WELL WATER TO BE USED AS: 5 Public water supply 8 Air conditioning 11 Injection well
 1 Domestic 3 Feedlot 6 Oil field water supply 9 Dewatering 12 Other (Specify below)
 2 Irrigation 4 Industrial 7 Lawn and garden only **10** Monitoring well
 Was a chemical/bacteriological sample submitted to Department? Yes.....No ; If yes, mo/day/yr sample was submitted
 Water Well Disinfected? Yes No

5 TYPE OF BLANK CASING USED: 5 Wrought iron 8 Concrete tile CASING JOINTS: Glued Clamped
 1 Steel 3 RMP (SR) 6 Asbestos-Cement 9 Other (specify below) Welded
2 PVC 4 ABS 7 Fiberglass Threaded.
 Blank casing diameter **2** in. to **24** ft, Dia in. to ft, Dia in. to ft
 Casing height above land surface **-2.16** in., weight Sch **40** lbs./ft Wall thickness or gauge No.
 TYPE OF SCREEN OR PERFORATION MATERIAL **7** PVC 10 Asbestos-cement
 1 Steel 3 Stainless steel 5 Fiberglass **8** RMP (SR) 11 Other (specify)
 2 Brass 4 Galvanized steel 6 Concrete tile 9 ABS 12 None used (open hole)
 SCREEN OR PERFORATION OPENINGS ARE: 5 Gauzed wrapped 8 Saw cut 11 None (open hole)
 1 Continuous slot **3** Mill slot 6 Wire wrapped 9 Drilled holes
 2 Louvered shutter 4 Key punched 7 Torch cut 10 Other (specify)
 SCREEN-PERFORATED INTERVALS: From **24** ft to **44** ft, From ft to ft
 From ft to ft, From ft to ft
 GRAVEL PACK INTERVALS: From **22** ft to **48** ft, From ft to ft
 From ft to ft, From ft to ft

6 GROUT MATERIAL: 1 Neat cement **2** Cement grout **3** Bentonite 4 Other
 Grout Intervals: From **0** ft to **20** ft, From **20** ft to **22** ft, From ft to ft
 What is the nearest source of possible contamination:
 1 Septic tank 4 Lateral lines 7 Pit privy 10 Livestock pens 14 Abandoned water well
 2 Sewer lines 5 Cess pool 8 Sewage lagoon 11 Fuel storage 15 Oil well/Gas well
 3 Watertight sewer lines 6 Seepage pit 9 Feedyard 12 Fertilizer storage **16** Other (specify below)
 **Former UST**
 Direction from well? **Northwest** How many feet? **20**

FROM	TO	LITHOLOGIC LOG	FROM	TO	PLUGGING INTERVALS
0	2	Clay, Dark Brown			
2	8	Clay, Brown			
8	15	Clay, Brown			
15	30	Clay, Brown			
30	48	Shale, Dark Gray			

MW3 , Tag # 00180197 , Flushmount
 Project Name: J -L Service
 GeoCore # 466 , KDHE # U4 023 1207

7 CONTRACTOR'S OR LANDOWNER'S CERTIFICATION: This water well was **1** constructed, (2) reconstructed, or (3) plugged under my jurisdiction and was completed on (mo/day/year) **6/18/97** and this record is true to the best of my knowledge and belief.
 Kansas Water Well Contractor's License No. **527** This Water Well Record was completed on (mo/day/yr) **8/8/97**
 under the business name of **GeoCore Services, Inc.** by (signature) *Dale A. Bell*