


1 LOCATION OF WATER WELL: County: Douglas	Fraction NW ¼ NW ¼ NW ¼	Section Number 3	Township Number T 15 S	Range Number R 20 (E/W)
---	-----------------------------------	----------------------------	----------------------------------	--

Distance and direction from nearest town or city street address of well if located within city?

Ames & Fifth Streets, Baldwin

2 WATER WELL OWNER: **J & L Service**
 RR#, St. Address, Box # : **Box 93**
 City, State, ZIP Code : **Baldwin, Kansas 66066**
 Board of Agriculture, Division of Water Resources
 Application Number:

3 LOCATE WELL'S LOCATION WITH AN "X" IN SECTION BOX:

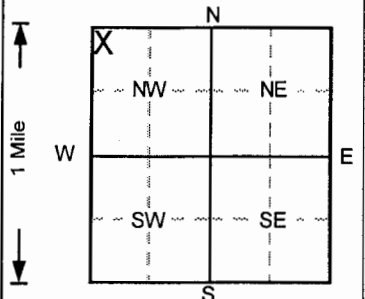

4 DEPTH OF COMPLETED WELL **25** ft. ELEVATION:

Depth(s) Groundwater Encountered 1. ft. 2. ft. 3. ft.

WELL'S STATIC WATER LEVEL . . . **10.6** . . . ft. below land surface measured on mo/day/yr **7/7/2006**

Pump test data: Well water was . . . **NA** . . . ft. after hours pumping gpm

Est. Yield . . **NA** . . gpm: Well water was ft. after hours pumping gpm

Bore Hole Diameter . . . **8** . . . in. to **25** . . . ft., and in. to ft.

WELL WATER TO BE USED AS: 5 Public water supply 8 Air conditioning 11 Injection well
 1 Domestic 3 Feedlot 6 Oil field water supply 9 Dewatering 12 Other (Specify below)
 2 Irrigation 4 Industrial 7 Lawn and garden only **10** Monitoring well

Was a chemical/bacteriological sample submitted to Department? Yes.....No ; If yes, mo/day/yr sample was submitted

Water Well Disinfected? Yes No

5 TYPE OF BLANK CASING USED: 5 Wrought iron 8 Concrete tile CASING JOINTS: Glued Clamped
 1 Steel 3 RMP (SR) 6 Asbestos-Cement 9 Other (specify below) Welded
2 PVC 4 ABS 7 Fiberglass Threaded.

Blank casing diameter **2** in. to **5** ft., Dia in. to ft., Dia in. to ft.

Casing height above land surface **0** in., weight lbs./ft. Wall thickness or gauge No. **Sch. 40**

TYPE OF SCREEN OR PERFORATION MATERIAL **7** PVC 10 Asbestos-cement
 1 Steel 3 Stainless steel 5 Fiberglass 8 RMP (SR) 11 Other (specify)
 2 Brass 4 Galvanized steel 6 Concrete tile 9 ABS 12 None used (open hole)

SCREEN OR PERFORATION OPENINGS ARE: 5 Gauzed wrapped 8 Saw cut 11 None (open hole)
 1 Continuous slot **3** Mill slot 6 Wire wrapped 9 Drilled holes
 2 Louvered shutter 4 Key punched 7 Torch cut 10 Other (specify)

SCREEN-PERFORATED INTERVALS: From **5** ft. to **25** ft., From ft. to ft.
 From ft. to ft., From ft. to ft.

GRAVEL PACK INTERVALS: From **4** ft. to **25** ft., From ft. to ft.
 From ft. to ft., From ft. to ft.

6 GROUT MATERIAL: 1 Neat cement 2 Cement grout **3** Bentonite **4** Other **Concrete**

Grout Intervals: From **0** ft. to **1** ft., From **1** ft. to **4** ft., From ft. to ft.

What is the nearest source of possible contamination:
 1 Septic tank 4 Lateral lines 7 Pit privy 10 Livestock pens 14 Abandoned water well
 2 Sewer lines 5 Cess pool 8 Sewage lagoon 11 Fuel storage 15 Oil well/Gas well
 3 Watertight sewer lines 6 Seepage pit 9 Feedyard 12 Fertilizer storage 16 Other (specify below)
 13 Insecticide storage

Direction from well? How many feet?

FROM	TO	LITHOLOGIC LOG	FROM	TO	PLUGGING INTERVALS
0	0.5	Gravel and clay,			
0.5	3.5	Clay, silty, moist, plastic, no odor, Grayish Br			
3.5	11	Clay, moist, plastic, no odor, Yellowish Brown			
11	14	Shale, sl. silty, firm, Lt. Yellowish Brown			
14	16	Shale, silty, sl. weathered, very firm, dry, Bro			
16	17.5	Shale and limestone interbedded, dry -, Gray			
17.5	19	Limestone, hard, Gray			
19	20	Shale, v. firm, dry, Brown			
20	23	Limestone, hard, saturated, Gray			
23	25	Shale, silty, saturated, Reddish Brown			
					MW17, Tag # 00369259, Flushmount
					Project Name: J L Service - Monitoring
					GeoCore # 773, KDHE # U4 023 01207

7 CONTRACTOR'S OR LANDOWNER'S CERTIFICATION: This water well was **1** constructed, (2) reconstructed, or (3) plugged under my jurisdiction and was completed on (mo/day/year) **7/7/2006** and this record is true to the best of my knowledge and belief.
 Kansas Water Well Contractor's License No. **527** This Water Well Record was completed on (mo/day/yr) **7/18/06**
 under the business name of **GeoCore, Inc.** by (signature) *Dale Kolb*