


1 LOCATION OF WATER WELL:	Fraction <u>Sub 1/4 Sub 1/4 NE 1/4</u>	Section Number <u>30</u>	Township Number <u>155</u>	Range Number <u>20E</u> E/W
----------------------------------	--	--------------------------	----------------------------	-----------------------------

Distance and direction from nearest town or city street address of well if located within city?
1.5 m NE of Ottawa on Stafford Terr.

2 WATER WELL OWNER: Jeffrey S. Fraser
Silver Dog Holding Co.
 RR #, St. Address, Box #: PO Box 189 Board of Agriculture, Division of Water Resources
 City, State, ZIP Code: Teton Village WY 83025-0189 Application Number: _____

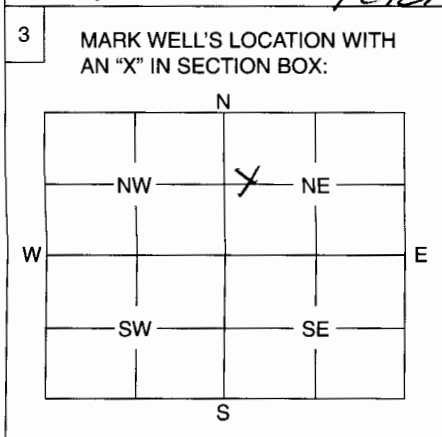

4 DEPTH OF WELL 200 ft.
 WELL'S STATIC WATER LEVEL 0 ft.
 WELL WAS USED AS:
 1 Domestic 5 Public Water Supply 9 Dewatering
 2 Irrigation 6 Oil Field Water Supply 10 Monitoring Well
 3 Feedlot 7 Domestic (Lawn & Garden) 11 Injection Well
 4 Industrial 8 Air Conditioning 12 Other test hole

Was a chemical / bacteriological sample submitted to Department? Yes No
 If yes, mo/day/yr sample was submitted

Water Well Disinfected: Yes No

5 TYPE OF BLANK CASING USED: none used

1 Steel 3 RMP (SR) 5 Wrought 7 Fiberglass 9 Other (Specify below)
 2 PVC 4 ABS 6 Asbestos-Cement 8 Concrete Tile

Blank casing diameter in. Was casing pulled? Yes No If yes, how much

Casing height above or below land surface in.

6 GROUT PLUG MATERIAL: 1 Neat cement 2 Cement grout 3 Bentonite 4 Other

Grout Plug Intervals: From 0 ft. to 30 ft., From ft. to ft., From to

What is the nearest source of possible contamination:
 1 Septic tank 6 Seepage pit 11 Fuel storage 16 Other (specify below)
 2 Sewer lines 7 Pit privy 12 Fertilizer storage

3 Watertight sewer lines 8 Sewage lagoon 13 Insecticide storage

4 Lateral lines 9 Feedyard 14 Abandoned water well

5 Cess pool 10 Livestock pens 15 Oil well/Gas well

Direction from well? nothing yet How many feet?

FROM	TO	PLUGGING MATERIALS
<u>0</u>	<u>30</u>	<u>Bentonite</u>
<u>30</u>	<u>200</u>	<u>Ag line</u>

7 CONTRACTOR'S OR LANDOWNER'S CERTIFICATION: This water well was plugged under my jurisdiction and was completed on (mo/day/year) 8/30/07 and this record is true to the best of my knowledge and belief. Kansas Water Well Contractor's License No. 595 This Water Well Record was completed on (mo/day/year) 8/30/07 under the business name of Jesse Yeakum Well Drilling by (signature) Jesse Yeakum

INSTRUCTIONS: Use typewriter or ball point pen. Please press firmly and print clearly. Please fill in blanks, underline or circle the correct answers. Send top three copies to Kansas Department of Health and Environment, Bureau of Water, Geology Section, 1000 SW Jackson St., Ste. 420, Topeka, Kansas 66612-1367. Telephone: 785/296-5522. Send one to Water Well Owner and retain one for your records.