


1 LOCATION OF WATER WELL: County: ~~Deage~~ Franklin Fraction: NW 1/4 NE 1/4 Section Number: 20 Township Number: T 15 S Range Number: R 21 E/W

Distance and direction from nearest town or city street address of well if located within city? ~~2. no north east 1/2 north of Melvern~~ Wellsville 1W 1N 1/2 West

2 WATER WELL OWNER: Jerry Rice RR#, St. Address, Box #: City, State, ZIP Code: Wellsville, Kan. Board of Agriculture, Division of Water Resources Application Number:

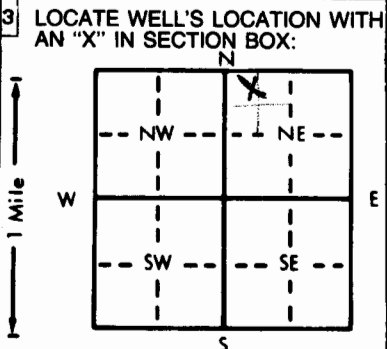

4 DEPTH OF COMPLETED WELL: 50 ft. ELEVATION: Depth(s) Groundwater Encountered: 1. 39 ft. 2. ft. 3. ft. WELL'S STATIC WATER LEVEL: 20 ft. below land surface measured on mo/day/yr Pump test data: Well water was ft. after hours pumping gpm Est. Yield: 5 gpm; Well water was ft. after hours pumping gpm Bore Hole Diameter: 9 in. to 20 ft., and 6 in. to 50 ft. WELL WATER TO BE USED AS: 5 Public water supply 8 Air conditioning 11 Injection well *1 Domestic 3 Feedlot 6 Oil field water supply 9 Dewatering 12 Other (Specify below) 2 Irrigation 4 Industrial 7 Lawn and garden only 10 Observation well Was a chemical/bacteriological sample submitted to Department? Yes No X; If yes, mo/day/yr sample was submitted Water Well Disinfected? Yes X No

5 TYPE OF BLANK CASING USED: 1 Steel 2 PVC *3 RMP (SR) 4 ABS 5 Wrought iron 6 Asbestos-Cement 7 Fiberglass 8 Concrete tile 9 Other (specify below) CASING JOINTS: Glued * Clamped Welded Threaded Blank casing diameter: 5 1/2 in. to 39 ft., Dia. Sch 40 in. to Sch 40 ft., Dia. Casing height above land surface: 24 in., weight lbs./ft. Wall thickness or gauge No. TYPE OF SCREEN OR PERFORATION MATERIAL: 1 Steel 2 Brass 3 Stainless steel 4 Galvanized steel 5 Fiberglass 6 Concrete tile 7 PVC 8 RMP (SR) 9 ABS 10 Asbestos-cement 11 Other (specify) 12 None used (open hole) SCREEN OR PERFORATION OPENINGS ARE: None 1 Continuous slot 2 Louvered shutter 3 Mill slot 4 Key punched 5 Gauzed wrapped 6 Wire wrapped 7 Torch cut 8 Saw cut 9 Drilled holes 10 Other (specify) 11 None (open hole) SCREEN-PERFORATED INTERVALS: From ft. to ft., From ft. to ft., From ft. to ft. GRAVEL PACK INTERVALS: None From ft. to ft., From ft. to ft., From ft. to ft.

6 GROUT MATERIAL: *1 Neat cement 2 Cement grout 3 Bentonite 4 Other Grout Intervals: From 3 ft. to 20 ft., From ft. to ft., From ft. to ft. What is the nearest source of possible contamination: 1 Septic tank 2 Sewer lines 3 Watertight sewer lines 4 Lateral lines *5 Cess pool 6 Seepage pit 7 Pit privy 8 Sewage lagoon 9 Feedyard 10 Livestock pens 11 Fuel storage 12 Fertilizer storage 13 Insecticide storage 14 Abandoned water well 15 Oil well/Gas well 16 Other (specify below) Direction from well? East How many feet? 110

FROM	TO	LITHOLOGIC LOG	FROM	TO	LITHOLOGIC LOG
0	10	Soil			
10	39	Yellow Sand Rock			
39	43	White Sand			
43	50	Shale			

7 CONTRACTOR'S OR LANDOWNER'S CERTIFICATION: This water well was (1) constructed, (2) reconstructed, or (3) plugged under my jurisdiction and was completed on (mo/day/year) 2-15-86 and this record is true to the best of my knowledge and belief. Kansas Water Well Contractor's License No. 469 This Water Well Record was completed on (mo/day/yr) 2-15-86 under the business name of Swank Drilling by (signature) [Signature]

INSTRUCTIONS: Use typewriter or ball point pen. PLEASE PRESS FIRMLY and PRINT clearly. Please fill in blanks, underline or circle the correct answers. Send top three copies to Kansas Department of Health and Environment, Office of Oil Field and Environmental Geology, Regulation and Permitting Section, Topeka, Kansas 66620-7500, Telephone: 913-862-9360. Send one to WATER WELL OWNER and retain one for your records.