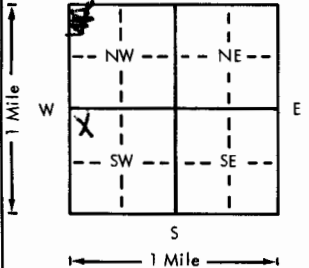
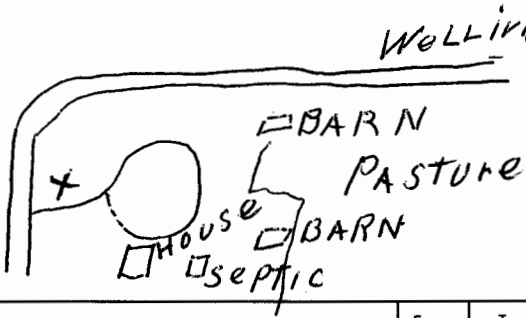


USE TYPEWRITER OR BALL
POINT PEN-PRESS FIRMLY,
PRINT CLEARLY.

WATER WELL RECORD
KSA 82a-1201-1215

Kansas Department of Health and
Environment-Division of Environment
(Water well Contractors)
Topeka, Kansas 66620

1. Location of well:		County <u>Discordia</u>	Fraction <u>1/4 1/4 S 1/4</u>	Section number <u>20</u>	Township number <u>T 15 S</u>	Range number <u>R 07 E/W</u>
2. Distance and direction from nearest town or city: <u>1 mile West Wellsville</u> Street address of well location if in city:			3. Owner of well: <u>Arlio Watts</u> R.R. or street: <u>L.I.</u> City, state, zip code: <u>Wellsville, Kansas</u>			
4. Locate with "X" in section below:		Sketch map:		6. Bore hole dia. <u>6</u> in. Completion date <u>11-25-76</u> Well depth _____ ft.		
				7. <input checked="" type="checkbox"/> Cable tool <input type="checkbox"/> Rotary <input type="checkbox"/> Driven <input type="checkbox"/> Dug <input type="checkbox"/> Hollow rod <input type="checkbox"/> Jetted <input type="checkbox"/> Bored <input type="checkbox"/> Reverse rotary		
5. Type and color of material		From	To	8. Use: <input type="checkbox"/> Domestic <input type="checkbox"/> Public supply <input type="checkbox"/> Industry <input type="checkbox"/> Irrigation <input type="checkbox"/> Air conditioning <input type="checkbox"/> Stock <input type="checkbox"/> Lawn <input type="checkbox"/> Oil field water <input type="checkbox"/> Other		
<u>Soil</u>				9. Casing: Material _____ Height: Above or below Threaded _____ Welded _____ Surface _____ in. RMP _____ PVC _____ Weight _____ lbs./ft.		
<u>Yellow Sand Rock</u>				Dia. _____ in. to _____ ft. depth Wall Thickness: inches or Dia. _____ in. to _____ ft. depth gage No. _____		
<u>Grey Shale</u>				10. Screen: Manufacturer's name _____ Type _____ Dia. _____ Slot/gauze _____ Length _____ Set between _____ ft. and _____ ft. _____ ft. and _____ ft. Gravel pack? _____ Size range of material _____		
				11. Static water level: _____ mo./day/yr. _____ ft. below land surface Date _____		
				12. Pumping level below land surfaces: _____ ft. after _____ hrs. pumping _____ g.p.m. _____ ft. after _____ hrs. pumping _____ g.p.m. Estimated maximum yield _____ g.p.m.		
				13. Water sample submitted: _____ mo./day/yr. Yes _____ No _____ Date _____		
				14. Well head completion: _____ Pitless adapter _____ Inches above grade		
				15. Well grouted? _____ With: _____ Neat cement _____ Bentonite _____ Concrete _____ Depth: From _____ ft. to _____ ft.		
				16. Nearest source of possible contamination: ft. _____ Direction _____ Type _____ Well disinfected upon completion? _____ Yes _____ No		
				17. Pump: _____ Not installed Manufacturer's name _____ Model number _____ HP _____ Volts _____ Length of drop pipe _____ ft. capacity _____ g.p.m. Type: _____ Submersible _____ Turbine _____ Jet _____ Reciprocating _____ Centrifugal _____ Other		
18. Elevation:		19. Remarks:		20. Water well contractor's certification: This well was drilled under my jurisdiction and this report is true to the best of my knowledge and belief. <u>Edgar Swanb</u> License No. _____ Address <u>1215 Ottawa, Kansas</u> Signed <u>Edgar Swanb</u> Date <u>12-30-76</u> Authorized representative		
Topography: <input type="checkbox"/> Hill <input type="checkbox"/> Slope <input checked="" type="checkbox"/> Upland <input type="checkbox"/> Valley		<u>HOLE WAS PLUGGED</u>				