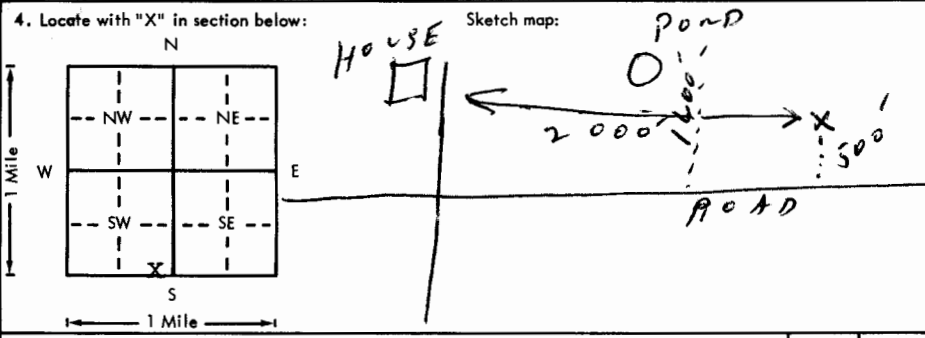


USE TYPEWRITER OR BALL POINT PEN—PRESS FIRMLY, PRINT CLEARLY.

WATER WELL RECORD
KSA 82a-1201-1215

Kansas Department of Health and Environment—Division of Environment
(Water well Contractors)
Topeka, Kansas 66620

1. Location of well:		County Johnson	Fraction SE 1/4 SE 1/4 SW 1/4	Section number 1	Township number T 15S	Range number S R 21E
2. Distance and direction from nearest town or city: 1 1/2 mi. west Edgerton, Kansas Street address of well location if in city:				3. Owner of well: Wm. H. Towles R.R. or street: 314 E. Main City, state, zip code: Gardner, Kansas 66030		
4. Locate with "X" in section below: 				6. Bore hole 2 1/2" DRY HOLE in. Completion date 8-12-76 Well depth 100 ft.		
5. Type and color of material				7. <input checked="" type="checkbox"/> Cable tool DRY HOLE <input type="checkbox"/> Driven <input type="checkbox"/> Dug <input type="checkbox"/> Hollow rod <input type="checkbox"/> Jetted <input type="checkbox"/> Bored <input type="checkbox"/> Reverse rotary		
				8. Use: <input type="checkbox"/> Domestic supply <input type="checkbox"/> Industry <input type="checkbox"/> Irrigation <input type="checkbox"/> Air conditioning <input type="checkbox"/> Stock <input type="checkbox"/> Lawn <input type="checkbox"/> Oil field water <input type="checkbox"/> Other		
				9. Casing: <input type="checkbox"/> Metal <input type="checkbox"/> Plastic Height: Above or below Threaded <input type="checkbox"/> Welded <input type="checkbox"/> Surface <input type="checkbox"/> in. RMP <input type="checkbox"/> PVC <input type="checkbox"/> Weight <input type="checkbox"/> lbs./ft. Dia. <input type="checkbox"/> in. to <input type="checkbox"/> ft. depth Wall Thickness: inches or Dia. <input type="checkbox"/> in. to <input type="checkbox"/> ft. depth gage No. <input type="checkbox"/>		
				10. Screen: Manufacturer's name DRY HOLE Type <input type="checkbox"/> Dia. <input type="checkbox"/> Slot/gauze <input type="checkbox"/> Length <input type="checkbox"/> Set between <input type="checkbox"/> ft. and <input type="checkbox"/> ft. <input type="checkbox"/> ft. and <input type="checkbox"/> ft. Gravel pack? <input type="checkbox"/> Size range of material <input type="checkbox"/>		
				11. Static water level DRY HOLE mo./day/yr. <input type="checkbox"/> ft. below land surface Date <input type="checkbox"/>		
				12. Pumping level below land surfaces: <input type="checkbox"/> ft. after <input type="checkbox"/> hrs. pumping <input type="checkbox"/> g.p.m. <input type="checkbox"/> ft. after <input type="checkbox"/> hrs. pumping <input type="checkbox"/> g.p.m. Estimated maximum yield <input type="checkbox"/> g.p.m.		
				13. Water sample analyzed: DRY HOLE mo./day/yr. <input type="checkbox"/> Yes <input type="checkbox"/> No Date <input type="checkbox"/>		
				14. Well head completion: <input type="checkbox"/> Pitless adapter <input type="checkbox"/> inches above grade		
				15. Well grouted? DRY HOLE With: <input type="checkbox"/> Neat cement <input type="checkbox"/> Bentonite <input type="checkbox"/> Concrete Depth: From <input type="checkbox"/> ft. to <input type="checkbox"/> ft.		
				16. Nearest source of possible contamination: ft. DRY HOLE Direction <input type="checkbox"/> Type <input type="checkbox"/> Well disinfected upon completion? <input type="checkbox"/> Yes <input type="checkbox"/> No		
				17. Pump: <input type="checkbox"/> Not installed Manufacturer's name DRY HOLE Model number <input type="checkbox"/> HP <input type="checkbox"/> Volts <input type="checkbox"/> Length of drop pipe <input type="checkbox"/> ft. capacity <input type="checkbox"/> g.p.m. Type: <input type="checkbox"/> Submersible <input type="checkbox"/> Turbine <input type="checkbox"/> Jet <input type="checkbox"/> Reciprocating <input type="checkbox"/> Centrifugal <input type="checkbox"/> Other		
				20. Water well contractor's certification: This well was drilled under my jurisdiction and this report is true to the best of my knowledge and belief. F.E. Young Drilling 240 Business name License No. Address 6355 Robinhood Ln. Signed F.E. Young Date 10-76 Authorized representative		
18. Elevation: 1010 1009 Topography: <input type="checkbox"/> Hill <input checked="" type="checkbox"/> Slope <input type="checkbox"/> Upland <input type="checkbox"/> Valley	19. Remarks: Customer is aware of State regulation and agrees to install a 4' square re-enforced concrete platform around top of well. X Wm H Towles					

Forward the white, blue and pink copies to the Department of Health and Environment

Form WWC-5