

CORRECTION(S) TO WATER WELL RECORD (WWC-5)

(to rectify lacking or incorrect information)

County: Franklin

Location listed as:

Location changed to:

Section-Township-Range: 27-21S-15E

27-15S-21E

Fraction ($\frac{1}{4}$ $\frac{1}{4}$ $\frac{1}{4}$): NW SE NE

NW SE NE

Other changes: Initial statements: 95.15919 Longitude

Changed to: 95.05919

Comments: Longitude changed to fit with other wells in this series
and with written description on attached "Well Installation Form."

verification method: Latitude & longitude, conversion tool on KGS website,
and Wellsville 1:24,000 topo. map.

initials: DRJ date: 2/17/2006

submitted by: Kansas Geological Survey, Data Resources Library, 1930 Constant Ave., Lawrence, KS 66047-3726

to: Kansas Dept of Health & Environment, Bureau of Water, 1000 SW Jackson, Suite 420, Topeka, KS 66612-1367.

□

INSTRUCTIONS: Use typewriter or ball point pen. PLEASE PRESS FIRMLY and PRINT clearly. Please fill in blanks, underline or circle the correct answers. Send top three copies to Kansas Department of Health and Environment, Bureau of Water, Geology Section, 1000 SW Jackson St., Suite 420, Topeka, Kansas 66612-1367. Telephone 785-296-5522. Send one to WATER WELL OWNER and retain one for your records. Fee of \$5.00 for each constructed well. Visit us at <http://www.kdhe.state.ks.us/geo/waterwells>.

Well Installation Form

WELL NUMBER

MW-7

COUNTY

Franklin

OVERSEEING GEOLOGIST

Lee Warfield - EWI

DRILLER

Xpert Drilling Servied (XDS)

WELL USAGE

Environmental Monitoring Well

DRILLING METHOD

Hollow Stem Auger

SAMPLING METHOD

Geoprobe

SITE NAME

BNSF Wellsville Derailment Site

BOREHOLE DIAMETER

8.25 inches

STATIC WATER LEVEL

SITE ADDRESS (approximate)

0.5 miles west of 4814 Fiber Lane, Wellsville, KS

TOTAL WELL DEPTH

14.0 feet

TOTAL BORING DEPTH

DATE OF CONSTRUCTION

10/28/2005

TOP OF CASING ELEVATION

1012 feet

GROUND SURFACE ELEVATION

1010 feet


WELL OWNER INFORMATION

BNSF Railway Company

4515 Kansas Avenue, Kansas City, Kansas 66106

Approximate Depth
(feet below ground
surface)

Lithographic Description and Remarks

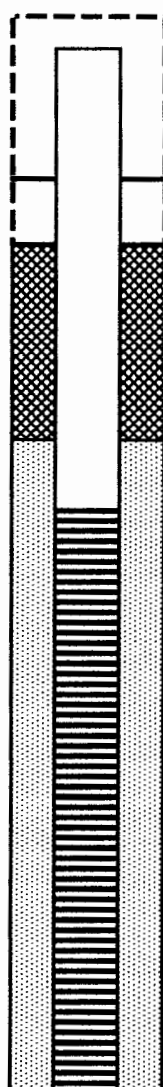

+ 3.0

+ 2.0

0.0

Dark brown top soil

2.0

Grey silty clay with brown mottling

4.0

6.0

Brown silty sand, slightly wet

8.0

Brown silty clay with grey mottling, moist starting at 10.0 feet

10.0

Wet at 11.0 feet, Brown sandy silt with slight orange mottling

12.0

Brown clay, stiff with grey mottling

14.0

16.0

COMMENTS:

Refusal @ 14.0 feet

RECEIVED

DEC 30 2005

BUREAU OF WATER



Bentonite Chips



Screen



Filter Pack