

**CORRECTION(S) TO WATER WELL RECORD (WWC-5)**

(to rectify lacking or incorrect information)

County: Franklin

Location listed as:

Section-Township-Range: 27-21S-15E

Fraction (  $\frac{1}{4}$   $\frac{1}{4}$   $\frac{1}{4}$ ): NW SE NE

Location changed to:

27-15S-21E

NW SE NE

Other changes: Initial statements: \_\_\_\_\_

Changed to: \_\_\_\_\_

Comments: \_\_\_\_\_

verification method: Latitude & longitude, conversion tool on KGS website,  
and Wellsville 1:24,000 topo. map.

initials: DRL date: 2/17/2006

**WATER WELL RECORD**

**Form WWC-5**

Division of Water Resources; App. No.  

<b>1 LOCATION OF WATER WELL:</b> County: <b>FRANKLIN</b>	Fraction <b>NW 1/4 SE 1/4 NE 1/4</b>	Section Number <b>27</b>	Township Number <b>T 21 S</b>	Range Number <b>R 15 <u>EW</u></b>
---	---	-----------------------------	----------------------------------	---------------------------------------


Distance and direction from nearest town or city street address of well if located within city?

**Global Positioning Systems** (decimal degrees, min. of 4 digits)

Latitude: **38.71923**  
 Longitude: **95.05929**  
 Elevation: **1010**  
 Datum: **WGS 84**  
 Data Collection Method: **GPS**

**2 WATER WELL OWNER:** **BNSF Railway Co**  
 RR#, St. Address, Box # : **4515 Kansas Ave**  
 City, State, ZIP Code : **Kansas City KS 66106**

**3 LOCATE WELL'S LOCATION WITH AN "X" IN SECTION BOX:**

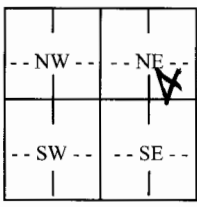

**4 DEPTH OF COMPLETED WELL** ..... **13.5** ..... ft.

Depth(s) Groundwater Encountered (1)..... ft. (2)..... ft. (3)..... ft.  
 WELL'S STATIC WATER LEVEL..... ft. below land surface measured on mo/day/yr.....  
 Pump test data: Well water was.....ft. after..... hours pumping..... gpm  
 Est. Yield.....gpm: Well water was.....ft. after..... hours pumping..... gpm  
**WELL WATER TO BE USED AS:** 5 Public water supply 8 Air conditioning 11 Injection well  
 1 Domestic 3 Feedlot 6 Oil field water supply 9 Dewatering 12 Other (Specify below)  
 2 Irrigation 4 Industrial 7 Domestic (lawn & garden) **10** Monitoring well .....

Was a chemical/bacteriological sample submitted to Department? Yes ..... No .....; If yes, mo/day/yr  
 Sample was submitted..... Water well disinfected? Yes ..... No .....

**5 TYPE OF CASING USED:** 5 Wrought Iron 8 Concrete tile CASING JOINTS: Glued..... Clamped.....  
 1 Steel 3 RMP (SR) 6 Asbestos-Cement 9 Other (specify below) Welded.....  
**2** PVC 4 ABS 7 Fiberglass ..... Threaded.....  
 Blank casing diameter ..... **2** ..... in. to **5.125** ..... ft., Diameter..... in. to ..... ft., Diameter..... in. to ..... ft.  
 Casing height above land surface..... **24** ..... in., Weight.....lbs./ft. Wall thickness or gauge No. **40** .....

**TYPE OF SCREEN OR PERFORATION MATERIAL:**  
 1 Steel 3 Stainless Steel 5 Fiberglass **0** PVC 9 ABS 11 Other (Specify) .....  
 2 Brass 4 Galvanized Steel 6 Concrete tile 8 RM (SR) 10 Asbestos-Cement 12 None used (open hole)

**SCREEN OR PERFORATION OPENINGS ARE:**  
**0** Continuous slot 3 Mill slot 5 Gauzed wrapped 7 Torch cut 9 Drilled holes 11 None (open hole)  
 2 Louvered shutter 4 Key punched 6 Wire wrapped 8 Saw Cut 10 Other (specify) .....

**SCREEN-PERFORATED INTERVALS:** From..... **5** ..... ft. to ..... **13.5** ..... ft., From ..... ft. to ..... ft.  
 From..... ft. to ..... ft., From ..... ft. to ..... ft.  
**GRAVEL PACK INTERVALS:** From..... ft. to ..... ft., From ..... ft. to ..... ft.  
 From..... ft. to ..... ft., From ..... ft. to ..... ft.

**6 GROUT MATERIAL:** 1 Neat cement 2 Cement grout **0** Bentonite 4 Other .....  
 Grout Intervals: From ..... **0** ..... ft. to ..... **3** ..... ft., From ..... ft. to ..... ft., From ..... ft. to ..... ft.

What is the nearest source of possible contamination:  
 1 Septic tank 4 Lateral lines 7 Pit privy 10 Livestock pens 13 Insecticide Storage 16 Other (specify below)  
 2 Sewer lines 5 Cess pool 8 Sewage lagoon 11 Fuel storage 14 Abandoned water well  
 3 Watertight sewer lines 6 Seepage pit 9 Feedyard 12 Fertilizer Storage 15 Oil well/gas well .....

Direction from well? ..... How many feet? .....

FROM	TO	LITHOLOGIC LOG	FROM	TO	PLUGGING INTERVALS
		<b>See Attached Log</b>			
		<b>MW-4</b>			

**7 CONTRACTOR'S OR LANDOWNER'S CERTIFICATION:** This water well was **0** constructed, (2) reconstructed, or (3) plugged under my jurisdiction and was completed on (mo/day/year) **10/22/2005** and this record is true to the best of my knowledge and belief. Kansas Water Well Contractor's License No. **753** ..... This Water Well Record was completed on (mo/day/year) **11-7-05** under the business name of **Environmental Works** by (signature) **Paul S. Hill**

**INSTRUCTIONS:** Use typewriter or ball point pen. PLEASE PRESS FIRMLY and PRINT clearly. Please fill in blanks, underline or circle the correct answers. Send top three copies to Kansas Department of Health and Environment, Bureau of Water, Geology Section, 1000 SW Jackson St., Suite 420, Topeka, Kansas 66612-1367. Telephone 785-296-5522. Send one to WATER WELL OWNER and retain one for your records. Fee of \$5.00 for each constructed well. Visit us at <http://www.kdhe.state.ks.us/geo/waterwells>.

# Well Installation Form

WELL NUMBER  
MW-4

DRILLER  
Xpert Drilling Servied (XDS)

SAMPLING METHOD  
Geoprobe

STATIC WATER LEVEL

TOTAL BORING DEPTH  
13.5 feet

GROUND SURFACE ELEVATION  
1010 feet

COUNTY  
Franklin

OVERSEEING GEOLOGIST  
Lee Warfield - EWI

WELL USAGE  
Monitoring Well

DRILLING METHOD  
Hollow Stem Auger

SITE NAME  
BNSF Wellsville Derailment Site

BOREHOLE DIAMETER  
8.25 inches

SITE ADDRESS (approximate)  
0.5 miles west of 4814 Fiber Lane, Wellsville, KS

TOTAL WELL DEPTH


DATE OF CONSTRUCTION  
10/28/2005

TOP OF CASING ELEVATION  
1012 feet

WELL OWNER INFORMATION  
BNSF Railway Company  
4515 Kansas Avenue, Kansas City, Kansas 66106

Approximate Depth (feet below ground surface)

Lithographic Description and Remarks

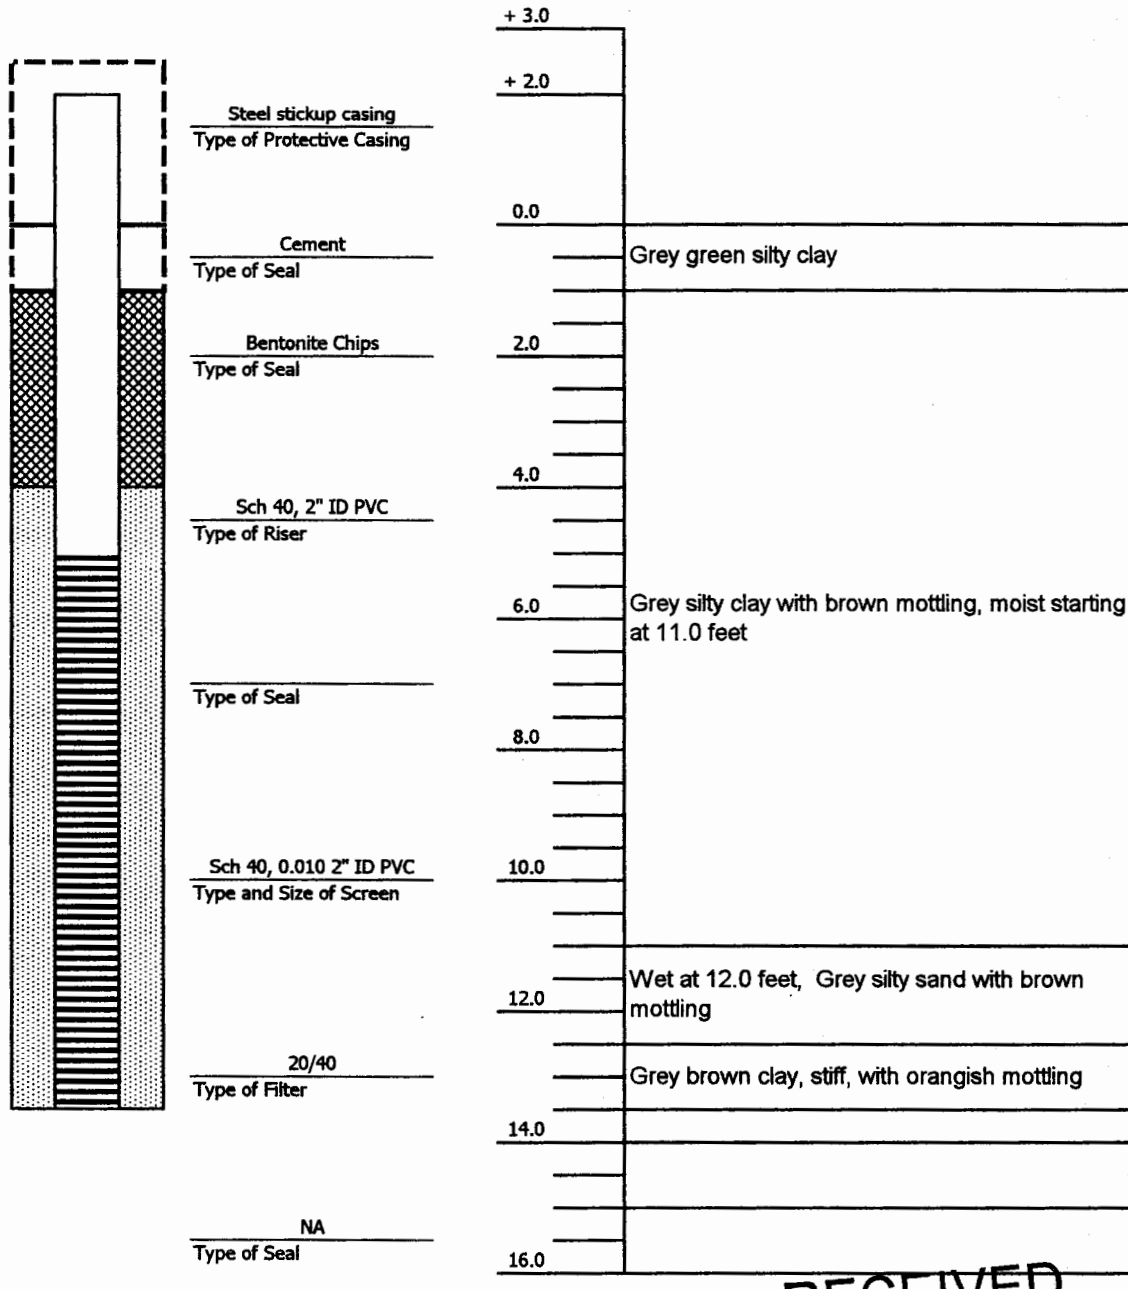

COMMENTS:  
Refusal @ 13.5 feet

RECEIVED

DEC 30 2005

BUREAU OF WATER

Bentonite Chips
  Screen
  Filter Pack