

TW6-010

WATER WELL RECORD


Form WWC-5

Division of Water Resources App. No.

1 LOCATION OF WATER WELL: County: Miami Fraction 1/4 SE 1/4 SE 1/4 SE 1/4 Section Number 26 Township No. T 15 S Range Number R 21 [X]E []W

Street/Rural Address of Well Location; if unknown, distance & direction from nearest town or intersection: 22640 Pleasant Valley Road, Wellsville, KS Global Positioning System (GPS) information: Latitude: 38.7104 Longitude: 95.0359 Elevation: 934

2 WATER WELL OWNER: Kansas Dept. of Transportation RR#, Street Address, Box #: 700 SW Harrison Street City, State, ZIP Code : Topeka, KS 66603 Collection Method: [X] GPS unit (Make/Model: Garmin 60)

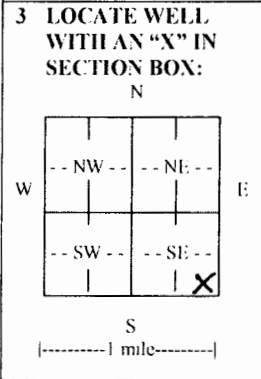

4 DEPTH OF COMPLETED WELL 16 ft. Depth(s) Groundwater Encountered (1) 14.66 ft. WELL'S STATIC WATER LEVEL 14.66 ft. below land surface Pump test data: Well water was 8 in. to 16 ft. after 16 hours pumping EST. YIELD 8 gpm. Bore Hole Diameter 8 in. to 16 ft. and 16 in. to 16 ft. WELL WATER TO BE USED AS: [X] Monitoring well

5 TYPE OF CASING USED: [X] PVC [] Steel [] Other CASING JOINTS: [X] Threaded [] Glued [] Clamped [] Welded Casing diameter 2 in. to 6 ft., Diameter 2 in. to 6 ft. Casing height above land surface 30 in., Weight lbs./ft., Wall thickness or gauge No. Sch. 40 TYPE OF SCREEN OR PERFORATION MATERIAL: [X] PVC [] Steel [] Stainless Steel [] Brass [] Galvanized Steel [] None used (open hole) SCREEN OR PERFORATION OPENINGS ARE: [X] Mill slot [] Continuous slot [] Gauze wrapped [] Torch cut [] Drilled holes [] None (open hole)

6 GROUT MATERIAL: [X] Bentonite [] Neat cement [] Cement grout [] Other Grout Intervals: From 1 ft. to 2 ft., From ft. to ft., From ft. to ft. What is the nearest source of possible contamination: [] Septic tank [] Lateral lines [] Pit privy [] Livestock pens [] Insecticide storage [] Other (specify below)

Table with 6 columns: FROM, TO, LITHOLOGIC LOG, FROM, TO, LITHO. LOG (cont.) or PLUGGING INTERVALS. Row 1: FROM 0, TO 16, Silty Clay.

7 CONTRACTOR'S OR LANDOWNER'S CERTIFICATION: This water well was [X] constructed, [] reconstructed, or [] plugged under my jurisdiction and was completed on (mo/day/year) 9/2/10 and this record is true to the best of my knowledge and belief. Kansas Water Well Contractor's License No. 710 This Water Well Record was completed on (mo/day/year) 9/23/10 under the business name of Below Ground Surface, Inc. by (signature) [Signature]

INSTRUCTIONS: Use typewriter or ball point pen. PLEASE PRESS FIRMLY and PRINT clearly. Please fill in blanks and check the correct answers. Send three copies (white, blue, pink) to Kansas Department of Health and Environment, Bureau of Water, Geology Section, 1000 SW Jackson St., Suite 420, Topeka, Kansas 66612-1367. Telephone 785-296-5522. Send one copy to WATER WELL OWNER and retain one for your records. Include fee of \$5.00 for each constructed well. Visit us at http://www.kdheks.gov/waterwell/index.html.