WATER WELL PLUGGING RECORD Form WWC-5P

KSA 82a-1212 1212309 LOG NO. 0000000000000000

1 LOCATION OF WATER WELL: County: Franklin | Fraction: NW ¼ SW¼ SW ¼ NW ¼ | Section Number: 20 | Township Number: 15 T S | Range Number: 21 ☐ E ☐ W

Street/Rural Address of Well Location; if unknown, distance & direction from nearest town or intersection: If at owner's address, check here ☑

Global Positioning Systems (GPS) information:
Latitude: 38.732592 (in decimal degrees)
Longitude: 95.111503 (in decimal degrees)
Elevation: 1050
Datum: ☐ WGS84, ☐ NAD83, ☑ NAD27
Collection Method:
☐ GPS unit (Make/Model: _____)
☐ Digital Map/Photo, ☑ Topographic Map, ☐ Land Survey
Est. Accuracy: ☐ < 3 m, ☑ 3-5 m, ☐ 5-15 m, ☐ > 15 m

2 WATER WELL OWNER: Ronnie McKay
RR#, St. Address, Box #: 4819 Utah
City, State ZIP Code: Wellsville KS 66092

3 MARK WELL'S LOCATION WITH AN "X" IN SECTION BOX:

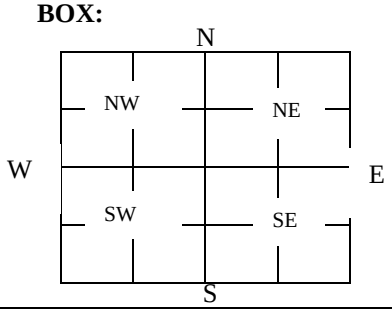

4 DEPTH OF WELL 200 ft.

WELL'S STATIC WATER LEVEL 0 ft

WELL WAS USED AS:

☑ Domestic ☐ Irrigation ☐ Feedlot ☐ Industrial
☐ Public Water Supply ☐ Oil Field Water Supply ☐ Domestic (Lawn & Garden) ☐ Air Conditioning
☐ Dewatering ☐ Monitoring ☐ Injection Well ☐ Other _____

Was a chemical/bacteriological sample submitted to Department? Yes ☐ No ☑

5 TYPE OF BLANK CASING USED:

☐ Steel ☐ PVC ☐ RMP (SR) ☐ ABS ☐ Wrought ☐ Asbestos-Cement ☐ Fiberglass ☐ Concrete Tile ☑ Other (Specify below) none

Blank casing diameter 0.00 in. Was casing pulled? Yes ☐ No ☑ If yes, how much _____
Casing height above or below land surface 0.0 in.

6 GROUT PLUG MATERIAL: ☐ Neat cement ☐ Cement grout ☑ Bentonite ☑ Other clorinated chat

Grout Plug Intervals: From 3 ft. to 75 ft., From _____ ft. to _____ft., From _____ ft. to _____ ft.

What is the nearest source of possible contamination:

☑ Septic tank ☐ Sewer lines ☐ Watertight sewer lines ☐ Lateral lines ☐ Cess pool
☐ Seepage pit ☐ Pit privy ☐ Sewage lagoon ☐ Feedyard ☐ Livestock pens
☐ Fuel storage ☐ Fertilizer storage ☐ Insecticide storage ☐ Abandoned water well ☐ Oil well/Gas well
☐ Other (specify below) _____
Direction from well? north
How many feet? 100

FROM	TO	PLUGGING MATERIALS	FROM	TO	PLUGGING MATERIALS
0	3	clay			
3	75	bentonite			
75	200	clorinated chat			

7 CONTRACTOR'S OR LANDOWNER'S CERTIFICATION: This water well was plugged under my jurisdiction and was completed on (mo/day/year) 08/13/2013 and this record is true to the best of my knowledge and belief. Kansas Water Well Contractor's License No. 595. This Water Well Record was completed on (mo/day/year) 06/26/2014 under the business name of Jesse Yoakum Well Drilling by (signature) _____

Send one white copy to Kansas Department of Health & Environment, Geology Section, 1000 SW Jackson Street, Ste. 420, Topeka, KS 66612-1367. Send one copy to WATER WELL OWNER and retain one for your records.
Visit us at http://www.kdheks.gov/waterwell/index.html Telephone 785-296-5524.