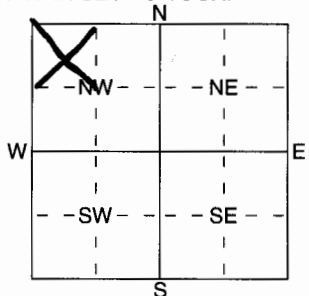


1 LOCATION OF WATER WELL: Fraction **NW 1/4 NW 1/4 SE 1/4** Section Number **7** Township Number **T 15 S** Range Number **R 22 E**
 County: **Johnson**
 Distance and direction from nearest town or city street address of well if located within city?
1002 North 2nd Street, Edgerton, KS

2 WATER WELL OWNER: **OTTAWA COOPERATIVE**
 RR#, St. Address, Box # : **P.O. BOX 650**
 City, State, ZIP Code : **OTTAWA, KS 66067**
 Board of Agriculture, Division of Water Resources
 Application Number:

3 LOCATE WELL'S LOCATION WITH AN "X" IN SECTION BOX:

 4 DEPTH OF COMPLETED WELL **9.95** ft. ELEVATION: **NA**
 Depth(s) Groundwater Encountered 1 ft. 2 ft. 3 ft.
 WELL'S STATIC WATER LEVEL **3.11** ft. below land surface measured on mo/day/yr **7/31/03**
 Pump test data: Well water was ft. after hours pumping gpm
 Est. Yield gpm: Well water was ft. after hours pumping gpm
 WELL WATER TO BE USED AS:
 1 Domestic 3 Feedlot 5 Public water supply 8 Air conditioning 11 Injection well
 2 Irrigation 4 Industrial 6 Oil field water supply 9 Dewatering 12 Other (Specify below)
 7 Domestic (lawn & garden) **10** Monitoring well
 Was a chemical/bacteriological sample submitted to Department? Yes No ; If yes, mo/day/yr sample was submitted
 Water Well Disinfected? Yes No

5 TYPE OF BLANK CASING USED:
 1 Steel 3 RMP (SR) 5 Wrought iron 8 Concrete tile CASING JOINTS: Glued Clamped
 2 **PVC** 4 ABS 7 Fiberglass 9 Other (specify below) Welded
 Blank casing diameter **1.5** in. to ft., Dia in. to ft., Dia in. to ft.
 Casing height above land surface in., weight lbs./ft. Wall thickness or gauge No.
 TYPE OF SCREEN OR PERFORATION MATERIAL:
 1 Steel 3 Stainless Steel 5 Fiberglass 8 RMP (SR) 10 Asbestos-Cement
 2 Brass 4 Galvanized Steel 6 Concrete tile 9 ABS 11 Other (Specify)
 12 None used (open hole)
 SCREEN OR PERFORATION OPENINGS ARE:
 1 Continuous slot 3 **Mill slot** 5 Gauzed wrapped 8 Saw cut 11 None (open hole)
 2 Louvered shutter 4 Key punched 6 Wire wrapped 9 Drilled holes
 7 Torch cut 10 Other (specify) ft.
 SCREEN-PERFORATED INTERVALS: From **5** ft. to **10** ft., From ft. to ft.
 GRAVEL PACK INTERVALS: From **3** ft. to **10** ft., From ft. to ft.

6 GROUT MATERIAL: 1 Neat cement 2 **Cement grout** 3 **Bentonite** 4 Other
 Grout Intervals: From **0** ft. to **1.5** ft., From **1.5** ft. to **3** ft., From ft. to ft.
 What is the nearest source of possible contamination:
 1 Septic tank 4 Lateral lines 7 Pit privy 10 Livestock pens 14 Abandoned water well
 2 Sewer lines 5 Cess pool 8 Sewage lagoon 11 Fuel storage 15 Oil well/Gas well
 3 Watertight sewer lines 6 Seepage pit 9 Feedyard 12 Fertilizer storage **16** Other (specify below) **COOP SITE**
 13 Insecticide storage
 Direction from well? How many feet?

FROM	TO	LITHOLOGIC LOG *	FROM	TO	PLUGGING INTERVALS
0	5	clay, dark brown			
5	10	clay, brown, gray			

7 CONTRACTOR'S OR LANDOWNER'S CERTIFICATION: This water well was (1) constructed, (2) reconstructed, or (3) plugged under my jurisdiction and was completed on (mo/day/year) **6/12/03** and this record is true to the best of my knowledge and belief. Kansas Water Well Contractor's Licence No **416** This Water Well Record was completed on (mo/day/yr) **5/21/04 REV. 8/27/04** under the business name of **TERRACON** by (signature) *[Signature]*

RECEIVED
 SEP 01 2004
 BUREAU OF WATER

* LOG OF PROBE EP-10,
 NORTHEAST OF MW-1. NO
 LOG WAS MADE OF MW-1.