


1 LOCATION OF WATER WELL: County: Miami Fraction: NE 1/4 NE 1/4 NE 1/4 Section Number: 35 Township Number: T 15 S Range Number: R 22 E

Distance and direction from nearest town or city street address of well if located within city?
29661 W 231 Spring Hill, KS.

2 WATER WELL OWNER: Wayne & Donna Wikstrom
 RR#, St. Address, Box #: 1225 Blackhawk Road APT. 105
 City, State, ZIP Code: Olathe, KS. 66067
 Board of Agriculture, Division of Water Resources
 Application Number: _____

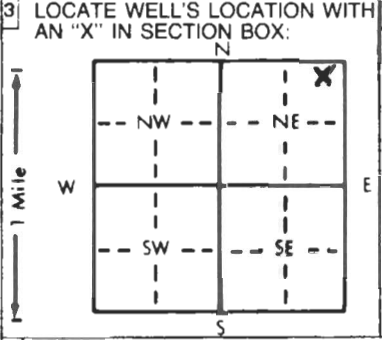

4 DEPTH OF COMPLETED WELLS: 200 ft. ELEVATION: 3 Wells all the SAME!
 Depth(s) Groundwater Encountered: 1. NONE ft. 2. _____ ft. 3. _____ ft.
 WELL'S STATIC WATER LEVEL: NONE ft. below land surface measured on mo/day/yr
 Pump test data: Well water was _____ ft. after _____ hours pumping _____ gpm
 Est. Yield: 0 gpm; Well water was _____ ft. after _____ hours pumping _____ gpm
 Bore Hole Diameter: 5/8 in. to _____ ft., and _____ in. to _____ ft.
 WELL WATER TO BE USED AS:
 5 Public water supply 8 Air conditioning 11 Injection well
 1 Domestic 3 Feedlot 6 Oil field water supply 9 Dewatering 12 Other (Specify below)
 2 Irrigation 4 Industrial 7 Lawn and garden only 10 Monitoring well Closed Loop heat Pump.
 Was a chemical/bacteriological sample submitted to Department? Yes _____ No X If yes, mo/day/yr sample was submitted _____
 Water Well Disinfected? Yes _____ No X

5 TYPE OF BLANK CASING USED:
 1 Steel 3 RMP (SR) 5 Wrought iron 8 Concrete tile CASING JOINTS: Glued _____ Clamped _____
 2 PVC 4 ABS 6 Asbestos-Cement 9 Other (specify below) Welded _____
 7 Fiberglass Threaded _____
 Blank casing diameter _____ in. to _____ ft., Dia _____ in. to _____ ft., Dia _____ in. to _____ ft.
 Casing height above land surface _____ in., weight _____ lbs./ft. Wall thickness or gauge No. _____
 TYPE OF SCREEN OR PERFORATION MATERIAL:
 1 Steel 3 Stainless steel 5 Fiberglass 8 RMP (SR) 10 Asbestos-cement
 2 Brass 4 Galvanized steel 6 Concrete tile 9 ABS 11 Other (specify) _____
 12 None used (open hole)
 SCREEN OR PERFORATION OPENINGS ARE:
 1 Continuous slot 3 Mill slot 5 Gauzed wrapped 8 Saw cut 11 None (open hole)
 2 Louvered shutter 4 Key punched 6 Wire wrapped 9 Drilled holes
 7 Torch cut 10 Other (specify) _____
 SCREEN-PERFORATED INTERVALS: From _____ ft. to _____ ft., From _____ ft. to _____ ft.
 From _____ ft. to _____ ft., From _____ ft. to _____ ft.
 GRAVEL PACK INTERVALS: From _____ ft. to _____ ft., From _____ ft. to _____ ft.
 From _____ ft. to _____ ft., From _____ ft. to _____ ft.

6 GROUT MATERIAL: 1 Neat cement 2 Cement grout 3 Bentonite 4 Other _____
 Grout intervals: From 200 ft. to 0 ft., From _____ ft. to _____ ft., From _____ ft. to _____ ft.
 What is the nearest source of possible contamination:
 1 Septic tank 4 Lateral lines 7 Pit privy 10 Livestock pens 14 Abandoned water well
 2 Sewer lines 5 Cess pool 8 Sewage lagoon 11 Fuel storage 15 Oil well/Gas well
 3 Watertight sewer lines 6 Seepage pit 9 Feedyard 12 Fertilizer storage 16 Other (specify below)
 13 Insecticide storage
 Direction from well? _____ How many feet? _____

FROM	TO	LITHOLOGIC LOG	FROM	TO	PLUGGING INTERVALS
<u>0</u>	<u>3</u>	<u>Soil + Clay</u>	<u>200</u>	<u>0</u>	<u>High Solids Bentonite</u>
<u>3</u>	<u>15</u>	<u>Limestone</u>			
<u>15</u>	<u>24</u>	<u>Shale</u>			
<u>24</u>	<u>62</u>	<u>Limestone</u>			<u>3 Wells Plugged!</u>
<u>62</u>	<u>130</u>	<u>Shale</u>			
<u>130</u>	<u>135</u>	<u>Limestone</u>			
<u>135</u>	<u>137</u>	<u>Shale</u>			
<u>137</u>	<u>155</u>	<u>Limestone</u>			
<u>155</u>	<u>200</u>	<u>Shale</u>			

7 CONTRACTOR'S OR LANDOWNER'S CERTIFICATION: This water well was (1) constructed, (2) reconstructed, or (3) plugged under my jurisdiction and was completed on (mo/day/year) 3-24-98 and this record is true to the best of my knowledge and belief. Kansas Water Well Contractor's License No. 561 This Water Well Record was completed on (mo/day/yr) 4-1-98 under the business name of Erans Energy Development, Inc. by signature [Signature]