

WATER WELL PLUGGING RECORD Form WWC-5P

KSA 82a-1212

ID NO.

1 LOCATION OF WATER WELL:	Fraction	Section Number	Township Number	Range Number
County: <u>Johnson</u>	<u>SE 1/4 SW 1/4 NW 1/4 NW 1/4</u>	<u>10</u>	T <u>15</u> S	<u>22</u> ☒ E ☐ W

Street/Rural Address of Well Location; if unknown, distance & direction from nearest town or intersection: If at owner's address, check here ☐ Water well is located approx. 1900' NE of Intersection of I-35 and Homestead Lane in Edgerton KS.


Global Positioning Systems (GPS) information:

Latitude: 38.764402778 (in decimal degrees)
 Longitude: 94.963000 (in decimal degrees)
 Elevation: 1015.46
 Horizontal Datum: ☐ WGS84, ☐ NAD83, ☐ NAD27
 Collection Method:

2 WATER WELL OWNER: Moussa Sobati
 RR#, St. Address, Box #: 9134 Woodend Road
 City, State ZIP Code: Edwardsville, KS 66111

☐ GPS unit (Make/Model):
☒ Digital Map/Photo, ☐ Topographic Map, ☐ Land Survey
 Est. Accuracy: ☒ < 3 m, ☐ 3-5 m, ☐ 5-15 m, ☐ > 15 m

3 MARK WELL'S LOCATION WITH AN "X" IN SECTION BOX:

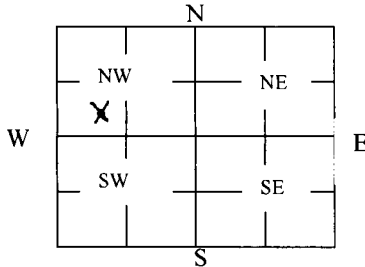

4 DEPTH OF WELL 21.87 ft.

WELL'S STATIC WATER LEVEL 17.6 ft

WELL WAS USED AS:

- | | | |
|---|---|---|
| ☐ Domestic | ☐ Public Water Supply | ☐ Dewatering |
| ☐ Irrigation | ☐ Oil Field Water Supply | ☐ Monitoring |
| ☒ Feedlot | ☐ Domestic (Lawn & Garden) | ☐ Injection Well |
| ☐ Industrial | ☐ Air Conditioning | ☐ Other |

Was a chemical/bacteriological sample submitted to Department? Yes ☐ No ☒

5 TYPE OF BLANK CASING USED:

- ☐ Steel ☐ RMP (SR) ☐ Wrought ☐ Fiberglass ☒ Other (Specify below)
☐ PVC ☐ ABS ☐ Asbestos-Cement ☐ Concrete Tile

Concrete walls on well

Blank casing diameter 12 ft. Was casing pulled? Yes ☒ No ☐ If yes, how much 40" Removed from Top
 Casing height above or below land surface 40 in.

6 GROUT PLUG MATERIAL: ☐ Neat cement ☐ Cement grout ☐ Bentonite ☒ Other 4000 PSI Concrete

Grout Plug Intervals: From 4.27 ft. to 3.27 ft., From _____ ft. to _____ ft., From _____ ft. to _____ ft.

What is the nearest source of possible contamination:

- | | | | |
|---|---|---|---|
| ☐ Septic tank | ☐ Seepage pit | ☐ Fuel storage | ☒ Other (specify below) |
| ☐ Sewer lines | ☐ Pit privy | ☐ Fertilizer storage | <u>2" water line (Public)</u> |
| ☐ Watertight sewer lines | ☐ Sewage lagoon | ☐ Insecticide storage | |
| ☐ Lateral lines | ☐ Feedyard | ☐ Abandoned water well | Direction from well? <u>NW</u> |
| ☐ Cess pool | ☐ Livestock pens | ☐ Oil well/Gas well | How many feet? <u>230'</u> |

FROM	TO	PLUGGING MATERIALS	FROM	TO	PLUGGING MATERIALS
<u>21.87'</u>	<u>4.27'</u>	<u>3/4" Clean Crushed Rock (1990 C.F.)</u>			
<u>4.27'</u>	<u>3.27'</u>	<u>12" Concrete Cap (155 C.F.)</u>			
<u>3.27'</u>	<u>0.00'</u>	<u>Soil (Clay) (500 C.F.)</u>			

7 CONTRACTOR'S OR LANDOWNER'S CERTIFICATION: This water well was plugged under my jurisdiction and was completed on (mo/day/year) 4/22/2020 and this record is true to the best of my knowledge and belief. Kansas Water Well Contractor's License No. 13757. This Water Well Record was completed on (mo/day/year) 4/22/2020 under the business name of Emery Sapp & Sons, Inc. by (signature) David J Taggart, PE

Send one white copy to Kansas Department of Health & Environment, Geology Section, 1000 SW Jackson Street, Ste. 420, Topeka, KS 66612-1367. Send one copy to WATER WELL OWNER and retain one for your records.

Visit us at <http://www.kdheks.gov/waterwell/index.html> Telephone 785-296-5524.

KSA82a-1212

Revised 1/20/2015