


1 LOCATION OF WATER WELL: Fraction NW ¼ NW¼ NW ¼ NW ¼ Section Number 11 Township Number T 15 S Range Number 22 E W
 County: Johnson

Street/Rural Address of Well Location; if unknown, distance & direction from nearest town or intersection: If at owner's address, check here W 199th St & Waverly Rd Edgerton, KS 66021

Global Positioning Systems (GPS) information:
 Latitude: 38.767249 (in decimal degrees)
 Longitude: -94.944920 (in decimal degrees)
 Elevation: _____
 Horizontal Datum: WGS84, NAD83, NAD27
 Collection Method: _____

2 WATER WELL OWNER: KDOT
 RR#, St. Address, Box #: 700 SW Harrison St, Floor 14
 City, State ZIP Code: Topeka, KS 66603

GPS unit (Make/Model): _____
 Digital Map/Photo, Topographic Map, Land Survey
 Est. Accuracy: < 3 m, 3-5 m, 5-15 m, > 15 m

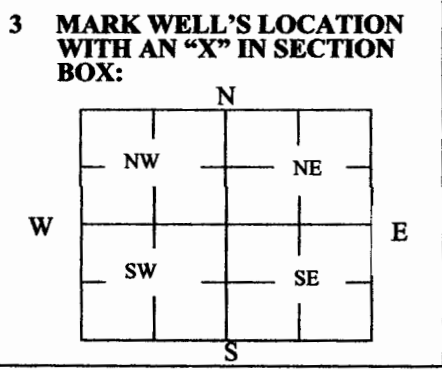

4 DEPTH OF WELL 16 ft.
WELL'S STATIC WATER LEVEL 6 ft.
WELL WAS USED AS:
 Domestic Public Water Supply Dewatering
 Irrigation Oil Field Water Supply Monitoring
 Feedlot Domestic (Lawn & Garden) Injection Well
 Industrial Air Conditioning Other Unknown
 Was a chemical/bacteriological sample submitted to Department? Yes No

5 TYPE OF BLANK CASING USED:
 Steel RMP (SR) Wrought Fiberglass Other (Specify below)
 PVC ABS Asbestos-Cement Concrete Tile
 Blank casing diameter _____ in. Was casing pulled? Yes No If yes, how much _____
 Casing height above or below land surface _____ in.

6 GROUT PLUG MATERIAL: Neat cement Cement grout Bentonite Other _____
 Grout Plug Intervals: From 6.5 ft. to 5 ft., From _____ ft. to _____ ft., From _____ ft. to _____ ft.
 What is the nearest source of possible contamination:
 Septic tank Seepage pit Fuel storage Other (specify below)
 Sewer lines Pit privy Fertilizer storage
 Watertight sewer lines Sewage lagoon Insecticide storage
 Lateral lines Feedyard Abandoned water well Direction from well? _____
 Cess pool Livestock pens Oil well/Gas well How many feet? _____

FROM	TO	PLUGGING MATERIALS	FROM	TO	PLUGGING MATERIALS
16	6.5	Sand			
6.5	5	Bentonite			
5	0	Clay and Soil			

7 CONTRACTOR'S OR LANDOWNER'S CERTIFICATION: This water well was plugged under my jurisdiction and was completed on (mo/day/year) 11/25/2020 and this record is true to the best of my knowledge and belief. Kansas Water Well Contractor's License No. 953. This Water Well Record was completed on (mo/day/year) 12/2/2020 under the business name of Allen's Holdings & Investments dba EED by (signature) [Signature]

Send one white copy to Kansas Department of Health & Environment, Geology Section, 1000 SW Jackson Street, Ste. 420, Topeka, KS 66612-1367. Send one copy to WATER WELL OWNER and retain one for your records.
 Visit us at <http://www.kdheks.gov/waterwell/index.html> Telephone 785-296-5524.

County: Johnson Fraction: NW, NW, NW, NW Sec. 11 T. 15 S R. 22 E

CORRECTION(S) to WATER WELL COMPLETION RECORD Form WWC-5 (to rectify lacking or incorrect information)

Owner: KDOT

If location corrected, was listed as:

Location changed to:

Section-Township-Range: _____

Fraction (¼ calls): _____

Other changes: Initial statements: Casing type, diameter, and amount removed were not reported.

Changed to: Rock casing was removed to 8-feet below land surface. Diameter of well was 72-inches.

Comments: _____

Verification method: Water well contractor was contacted and he provided the information.

Initials: PKC Date: 2/8/2021

Submitted by: Kansas Geological Survey, Data Resources Library, 1930 Constant Ave., Lawrence, KS 66047-3724
 Kansas Dept. of Health & Environment, Bureau of Water, 1000 SW Jackson, Suite 420, Topeka, KS 66612-1367