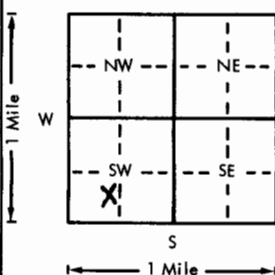
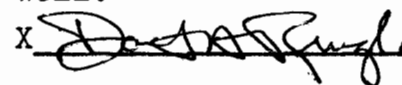


USE TYPEWRITER OR BALL
POINT PEN-PRESS FIRMLY,
PRINT CLEARLY.

WATER WELL RECORD
KSA 82a-1201-1215

Kansas Department of Health and
Environment-Division of Environment
(Water well Contractors)
Topeka, Kansas 66620

1. Location of well:		County Johnson	Section number 7	Township number T 15 S	Range number R 23 E/W
2. Distance and direction from nearest town or city: 4 mi. SE Street address of well location if in city: Gardner, Ks.		3. Owner of well: David A. Ringle R.R. or street: Rt. 1 City, state, zip code: Spring Hill, Kansas 66083			
4. Locate with "X" in section below: 		6. Bore hole dia. 8 1/2 in. Completion date 7-15-76 Well depth 230 ft.			
5. Type and color of material		7. <input checked="" type="checkbox"/> Cable tool <input type="checkbox"/> Rotary <input type="checkbox"/> Driven <input type="checkbox"/> Dug <input type="checkbox"/> Hollow rod <input type="checkbox"/> Jetted <input type="checkbox"/> Bored <input type="checkbox"/> Reverse rotary			
Surface		8. Use: <input checked="" type="checkbox"/> Domestic <input type="checkbox"/> Public supply <input type="checkbox"/> Industry <input type="checkbox"/> Irrigation <input type="checkbox"/> Air conditioning <input type="checkbox"/> Stock <input type="checkbox"/> Lawn <input type="checkbox"/> Oil field water <input type="checkbox"/> Other			
Clay-----brown		9. Casing: Material PVC Height: Above or below 12 in. Threaded <input type="checkbox"/> Welded <input checked="" type="checkbox"/> Surface 2 1/2 lbs./ft. RMP 6 in. to 192 ft. depth Wall Thickness 5/16 inches or Dia. 6 in. to 192 ft. depth gage No. 5/16			
Lime----grey		10. Screen: Manufacturer's name Pioneer Mfg. Co. Type RMP PVC Dia. 6 Slot/gauze see note length 172' Set between 20 ft. and 192 ft. Gravel pack? <input checked="" type="checkbox"/> Size range of material 1/4 x 1/8			
Shale---gray		11. Static water level: 20 ft. below land surface Date 7-5-76			
Lime---white		12. Pumping level below land surfaces: ____ ft. after ____ hrs. pumping ____ g.p.m. ____ ft. after ____ hrs. pumping ____ g.p.m. Estimated maximum yield 12 g.p.m.			
Shale----grey		13. Water sample submitted: ____ mo./day/yr. Yes <input checked="" type="checkbox"/> No <input type="checkbox"/> Date ____			
Lime000grey		14. Well head completion: well cap <input checked="" type="checkbox"/> Pitless adapter 12 inches above grade			
Shale		15. Well grouted? yes With: <input checked="" type="checkbox"/> Neat cement <input type="checkbox"/> Bentonite <input type="checkbox"/> Concrete Depth: From 5 ft. to 20 ft.			
Lime---grey		16. Nearest source of possible contamination: ft. 150 Direction NE Type Septic Well disinfected upon completion? <input checked="" type="checkbox"/> Yes <input type="checkbox"/> No			
Shale---black		17. Pump: <input type="checkbox"/> Not installed Manufacturer's name Goulds Model number 7EH HP 3/4 volt 230 Length of drop pipe 170 ft. capacity 8 g.p.m. Type: <input checked="" type="checkbox"/> Submersible <input type="checkbox"/> Turbine <input type="checkbox"/> Jet <input type="checkbox"/> Reciprocating <input type="checkbox"/> Centrifugal <input type="checkbox"/> Other			
Hole plugged back with cement to 192'		20. Water well contractor's certification: This well was drilled under my jurisdiction and this report is true to the best of my knowledge and belief. F. E. Young Drilling Co. 240 Business name 6355 Robinhood Merriam License No. 17-1-550 Address 826-76 Signed F. E. Young Date 8-26-76 Authorized representative			
18. Elevation: 991 Topography: 1021 <input checked="" type="checkbox"/> Hill <input type="checkbox"/> Slope <input type="checkbox"/> Upland <input type="checkbox"/> Valley		19. Remarks: Customer is aware of State regulation and agrees to install a 4' square re-enforced concrete platform around top of well. X 			

Forward the white, blue and pink copies to the Department of Health and Environment

Form WWC-5