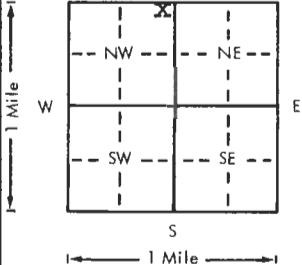


USE TYPEWRITER OR BALL POINT PEN-PRESS FIRMLY, PRINT CLEARLY.

WATER WELL RECORD
KSA 82a-1201-1215

Kansas Department of Health and Environment-Division of Environment
(Water well Contractors)
Topeka, Kansas 66620

1. Location of well:	County Miami	Fraction NE 1/4 NE 1/4 NW 1/4	Section number 19	Township number T 15 S R	Range number 23 E/W
2. Distance and direction from nearest town or city: 4 miles east & 2 miles south of Edgerton, Kansas		3. Owner of well: Mr. Dave Hill R.R. or street: 800 North Center Street City, state, zip code: Gardner, Kansas 66030			
4. Locate with "X" in section below: <div style="text-align:center;">N 1 Mile W  E S 1 Mile</div>		Sketch map:		6. Bore hole dia. 8 in. Completion date 8-8-77 Well depth 200 ft.	
5. Type and color of material		From		To	
Top Soil		0		1	
Clay		1		8	
Lime		8		21	
Shale		21		25	
Slate		25		28	
Lime		28		37	
Shale		37		43	
Lime		43		59	
Shale		59		67	
Red Bed		67		72	
Shale		72		85	
Lime		85		100	
Shale		100		180	
Lime		180		187	
Shale		187		192	
Lime		192		200	
(Use a second sheet if needed)					
18. Elevation: Topography: ___ Hill ___ Slope ___ Upland ___ Valley		19. Remarks:		20. Water well contractor's certification: This well was drilled under my jurisdiction and this report is true to the best of my knowledge and belief. BREJERK INC. 174 Business name Address: Box 117, Basenor, Ks. 66007 Signed: <i>[Signature]</i> Date: 8/10/77 Authorized representative	

Forward the white, blue and pink copies to the Department of Health and Environment

Form WWC-5