

☒ Original Record ☐ Correction ☐ Change in Well Use

[illegible]

NOTE: Figures exhibited within this report are only to be used within the context of this report. Placement of property lines, wells, structures, and roads is based on the available information from county appraiser maps, surveys, site visits, and/or previous vendor reports and should be considered approximate. Estimated concentration lines represent estimated contaminant concentrations based on data collected during the sampling event. Actual extent or concentration of contamination beyond the sample point is unknown.

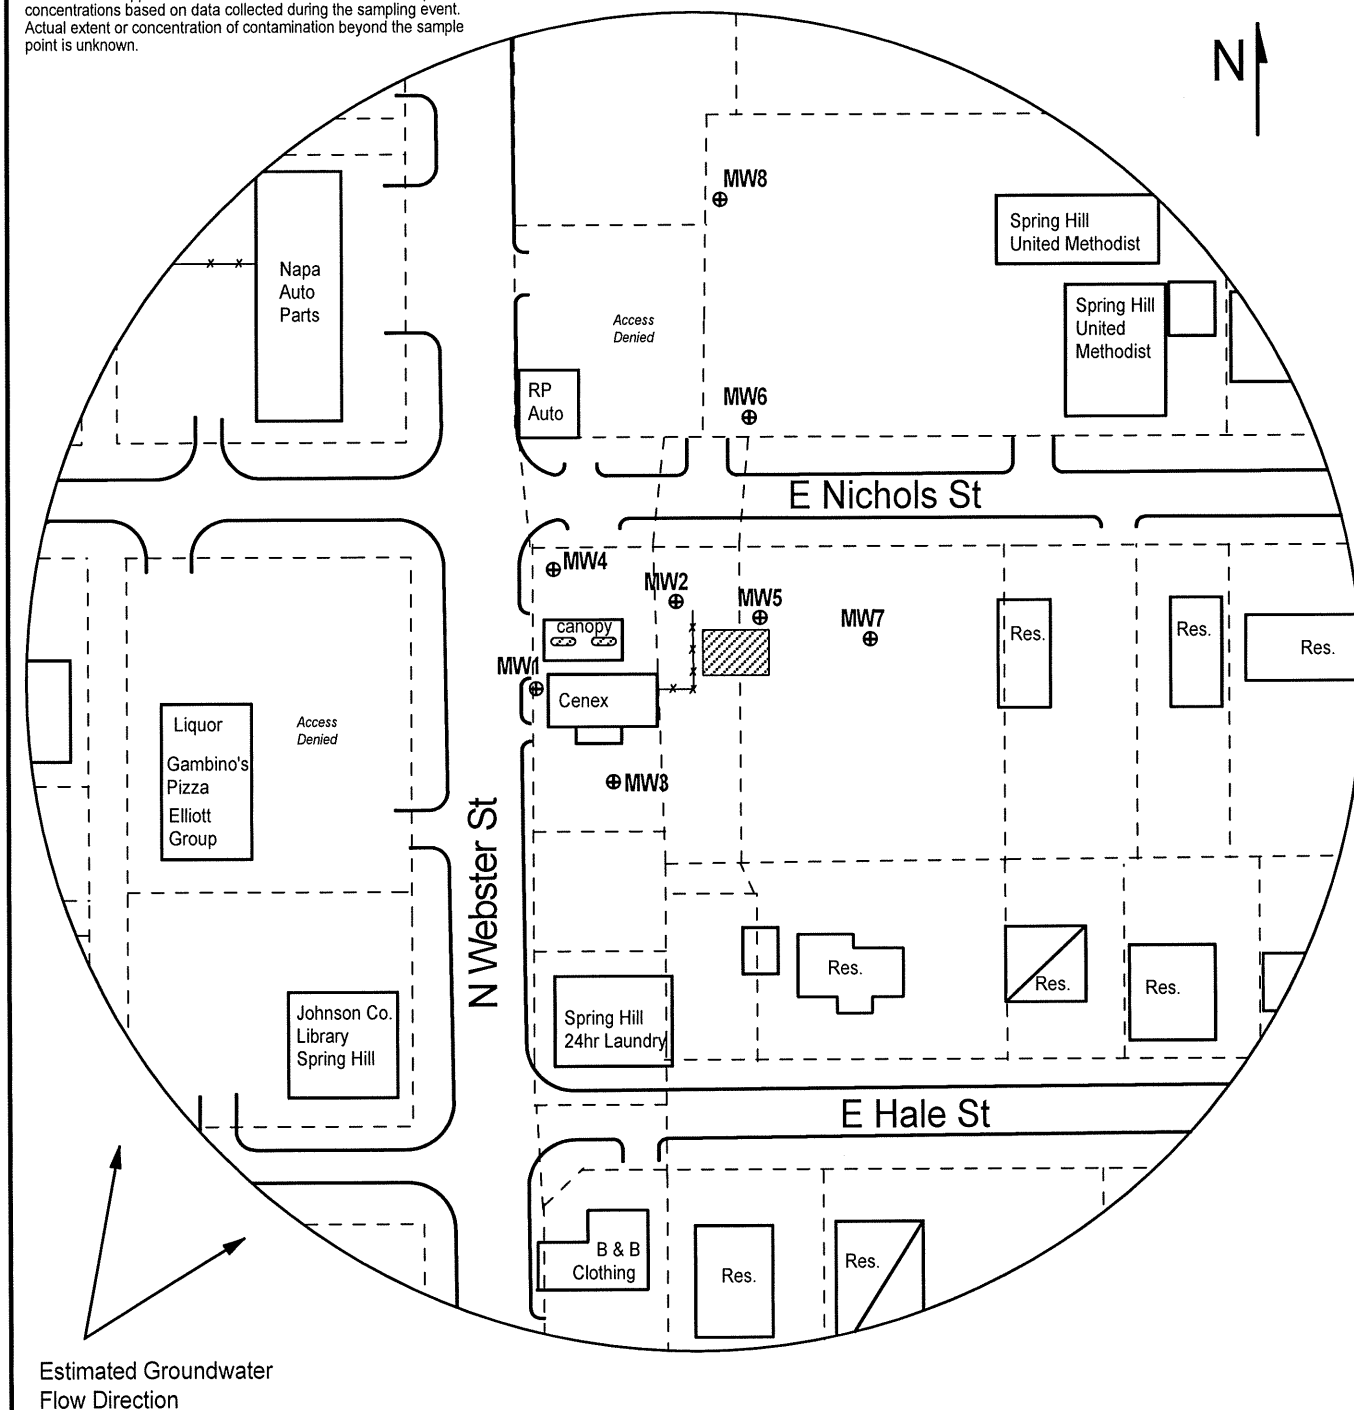


FIGURE 2.1 - 350 FT RADIUS AREA BASE MAP



PROJECT:

C&H Quick Shop
102 S. Webster
Spring Hill, KS
KDHE ID: U4-046-15421
Date: 3/8/23

0 100 ft

LEGEND:

- Approximate Location of Current UST Basin and Pump Island
- Building with Basement
- New Monitoring Well (Installed 2/13-14/23)
- Soil Boring (Drilled 2/15/23)
- Overhead Lines
- Sanitary Sewer (2 - 6 ft BGS)
- Water Line (2 - 6 ft BGS)
- Gas Line (2 - 6 ft BGS)

NOTE: Utility depths and locations are approximate.

1311 E 25th St., Suite B (785) 841-8707 office
Lawrence, KS 66046 (785) 865-4282 fax