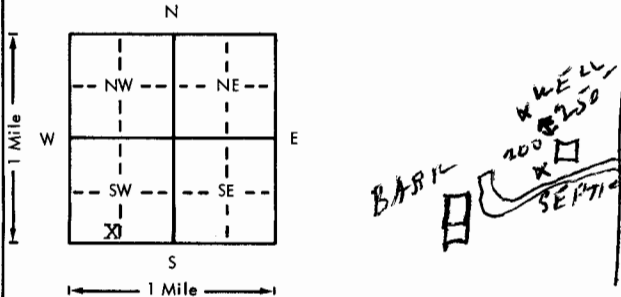


4

USE TYPEWRITER OR BALL POINT PEN-PRESS FIRMLY, PRINT CLEARLY.

WATER WELL RECORD  
KSA 82a-1201-1215

Kansas Department of Health and Environment-Division of Environment  
(Water well Contractors)  
Topeka, Kansas 66620

1. Location of well: County <b>Miami</b>		Fraction <b>SW 1/4 SW 1/4 SE 1/4</b>		Section number <b>25</b>		Township number <b>T 15 S R 24</b>		Range number <b>24</b>	
2. Distance and direction from nearest town or city: Street address of well location if in city: <b>3 SE BUCYRUS MAN</b>				3. Owner of well: <b>W. Donald Rooney</b> R.R. or street: <b>Route 1</b> City, state, zip code: <b>Bucyrus, Ks. 66013</b>					
4. Locate with "X" in section below: N W E S 1 Mile Sketch map: 				6. Bore hole dia. <b>8 1/2</b> in. Completion date <b>2-1-77</b> Well depth <b>160</b> ft.		7. <input checked="" type="checkbox"/> Cable tool <input type="checkbox"/> Rotary <input type="checkbox"/> Driven <input type="checkbox"/> Dug <input type="checkbox"/> Hollow rod <input type="checkbox"/> Jetted <input type="checkbox"/> Bored <input type="checkbox"/> Reverse rotary			
5. Type and color of material				8. Use: <input checked="" type="checkbox"/> Domestic <input type="checkbox"/> Public supply <input type="checkbox"/> Industry <input type="checkbox"/> Irrigation <input type="checkbox"/> Air conditioning <input type="checkbox"/> Stock <input type="checkbox"/> Lawn <input type="checkbox"/> Oil field water <input type="checkbox"/> Other		9. Casing: Material _____ Height: Above or below Threaded _____ Welded <input checked="" type="checkbox"/> Surface _____ in. RMP _____ PVC <input checked="" type="checkbox"/> Weight <b>1.75</b> lbs./ft. Dia. <b>5</b> in. to _____ ft. depth Wall thickness _____ inches or Dia. _____ in. to _____ ft. depth gauge No. <b>74 MNC</b>			
surface		From <b>0</b>		To <b>3</b>		10. Screen: Manufacturer's name <b>Robintech</b> Type <b>PVC</b> Dia. <b>5"</b> Slot/gauge <b>drill/slot</b> length <b>137'</b> Set between <b>23</b> ft. and <b>160</b> ft. _____ ft. and _____ ft. Gravel pack? <input checked="" type="checkbox"/> Size range of material <b>1/8-1/4</b>			
clay (brown)		From <b>3</b>		To <b>17</b>		11. Static water level: _____ mo./day/yr. <b>30</b> ft. below land surface Date <b>2-1-77</b>			
shale (grey)		From <b>17</b>		To <b>20</b>		12. Pumping level below land surfaces: _____ ft. after _____ hrs. pumping _____ g.p.m. _____ ft. after _____ hrs. pumping _____ g.p.m. Estimated maximum yield <b>1/2</b> g.p.m.			
lime (grey)		From <b>20</b>		To <b>23</b>		13. Water sample submitted: _____ mo./day/yr. Yes <input type="checkbox"/> No <input checked="" type="checkbox"/> Date _____			
shale (grey) (green)		From <b>23</b>		To <b>30</b>		14. Well head completion: <b>WELL CAP</b> _____ Pitless adapter <b>12</b> Inches above grade			
lime (grey)		From <b>30</b>		To <b>38</b>		15. Well grouted? <input checked="" type="checkbox"/> <b>yes</b> With: <input checked="" type="checkbox"/> Neat cement _____ Bentonite _____ Concrete _____ Depth: From <b>5</b> ft. to <b>25</b> ft.			
shale (lt. grey)		From <b>38</b>		To <b>44</b>		16. Nearest source of possible contamination: _____ ft. _____ Direction <b>W</b> Type <b>SEPTIC</b> Well disinfected upon completion? <input checked="" type="checkbox"/> Yes _____ No			
lime (lt. grey)		From <b>44</b>		To <b>81</b>		17. Pump: _____ Not installed Manufacturer's name _____ Model number _____ HP _____ Volts _____ Length of drop pipe _____ ft. capacity _____ g.p.m. Type: _____ <input type="checkbox"/> Submersible _____ Turbine _____ <input type="checkbox"/> Jet _____ Reciprocating _____ <input type="checkbox"/> Centrifugal _____ Other _____			
shale (grey)		From <b>81</b>		To <b>84</b>		18. Elevation: <b>1070</b> Topography: _____ Hill <input checked="" type="checkbox"/> Slope _____ Upland _____ Valley			
lime		From <b>84</b>		To <b>125</b>		19. Remarks: Customer is aware of State regulation and agrees to install a 4" square re-enforced concrete platform around top of well. <input checked="" type="checkbox"/> <u>W. Donald Rooney</u>			
shale (grey)		From <b>125</b>		To <b>159</b>		20. Water well contractor's certification: This well was drilled under my jurisdiction and this report is true to the best of my knowledge and belief. <b>F.E. Young Drilling Co. 240</b> Business name _____ License No. _____ Address <b>6555 Robinhood Ln.</b> Signed <u>F.E. Young</u> Date <b>3-9-77</b> Authorized representative			
lime (white)		From <b>159</b>		To <b>160</b>		casing drilled and slotted 23' to 160' perforation size : 3/32 (Use a second sheet if needed)			

T 15 S 24 W 25 SW SW SE  
1/4 1/4 1/4 1/4

Forward the white, blue and pink copies to the Department of Health and Environment

Form WWC-5