


1 LOCATION OF WATER WELL: County: **JOHNSON** Fraction: **NE 1/4 NW 1/4 NW 1/4** Section Number: **14** Township Number: **T 15 S** Range Number: **R 25 E/W**

Distance and direction from nearest town or city street address of well if located within city?
2 MILES EAST & 1 MILE SOUTH OF STILLWELL, KS

2 WATER WELL OWNER: **TIM TRABON**
 RR#, St. Address, Box #: **430 E. 95TH** Board of Agriculture, Division of Water Resources
 City, State, ZIP Code: **KC MO 64131** Application Number:

3 LOCATE WELL'S LOCATION WITH AN "X" IN SECTION BOX:

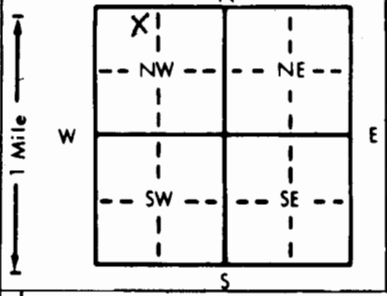

4 DEPTH OF COMPLETED WELL: **240** ft. ELEVATION:

Depth(s) Groundwater Encountered 1. **80** ft. 2. **204** ft. 3. _____ ft.
 WELL'S STATIC WATER LEVEL **80** ft. below land surface measured on mo/day/yr
 Pump test data: Well water was _____ ft. after _____ hours pumping _____ gpm
 Est. Yield **256PH** Well water was _____ ft. after _____ hours pumping _____ gpm
 Bore Hole Diameter: **8 1/2** in. to **240** ft., and _____ in. to _____ ft.
 WELL WATER TO BE USED AS:
 1 Domestic 3 Feedlot 6 Oil field water supply 9 Dewatering 12 Other (Specify below)
 2 Irrigation 4 Industrial 7 Lawn and garden only 10 Observation well
 Was a chemical/bacteriological sample submitted to Department? Yes _____ No If yes, mo/day/yr sample was submitted _____
 Water Well Disinfected? Yes No _____

5 TYPE OF BLANK CASING USED:
 1 Steel 3 RMP (SR) 5 Wrought iron 8 Concrete tile CASING JOINTS: Glued Clamped
 2 PVC 4 ABS 6 Asbestos-Cement 9 Other (specify below) Welded _____
 7 Fiberglass Threaded _____

Blank casing diameter **180** in. to **160** ft., Dia. **140** in. to **100** ft., Dia. **60** in. to **0** ft.
 Casing height above land surface **24** in., weight **1.5** lbs./ft. Wall thickness or gauge No. **200**

TYPE OF SCREEN OR PERFORATION MATERIAL:
 1 Steel 3 Stainless steel 5 Fiberglass 8 RMP (SR) 10 Asbestos-cement
 2 Brass 4 Galvanized steel 6 Concrete tile 9 ABS 12 None used (open hole)

SCREEN OR PERFORATION OPENINGS ARE:
 1 Continuous slot 3 Mill slot 5 Gauzed wrapped 8 Saw cut 11 None (open hole)
 2 Louvered shutter 4 Key punched 6 Wire wrapped 9 Drilled holes
 7 Torch cut 10 Other (specify) _____

SCREEN-PERFORATED INTERVALS: From **240** ft. to **180** ft., From **160** ft. to **140** ft.
 From **100** ft. to **60** ft., From _____ ft. to _____ ft.
 GRAVEL PACK INTERVALS: From **240** ft. to **24** ft., From _____ ft. to _____ ft.
 From _____ ft. to _____ ft., From _____ ft. to _____ ft.

6 GROUT MATERIAL: 1 Neat cement 2 Cement grout 3 Bentonite 4 Other
 Grout intervals: From **24** ft. to **3** ft., From _____ ft. to _____ ft.

What is the nearest source of possible contamination:
 1 Septic tank 4 Lateral lines 7 Pit privy 10 Livestock pens 14 Abandoned water well
 2 Sewer lines 5 Cess pool 8 Sewage lagoon 11 Fuel storage 15 Oil well/Gas well
 3 Watertight sewer lines 6 Seepage pit 9 Feedyard 12 Fertilizer storage 16 Other (specify below)
 13 Insecticide storage **CREEK**
 Direction from well? **WEST** How many feet? **500**

FROM	TO	LITHOLOGIC LOG	FROM	TO	LITHOLOGIC LOG
0	1	SURFACE	197	204	SHALE (DARK)
1	9	CLAY	204	225	LIME
9	25	LIMESTONE	225	229	SHALE
25	69	SHALE	229	230	LIME
69	75	LIMESTONE	230	231	SHALE
75	76	SHALE	231	233	LIME
76	83	LIMESTONE	233	237	SHALE
83	106	SHALE	237	240	LIME
106	110	LIME			
110	150	SHALE (DARK)			
150	156	LIME			
156	173	SHALE			
173	194	LIME			
194	195	SHALE			
195	197	LIME			

(DUPLICATE)

7 CONTRACTOR'S OR LANDOWNER'S CERTIFICATION: This water well was (1) constructed, (2) reconstructed, or (3) plugged under my jurisdiction and was completed on (mo/day/year) **10/8/88** and this record is true to the best of my knowledge and belief. Kansas Water Well Contractor's License No. **240** This Water Well Record was completed on (mo/day/yr) **11/10/88** under the business name of **F.F. YOUNG DRILLING CO** by (signature) **F.F. Young**