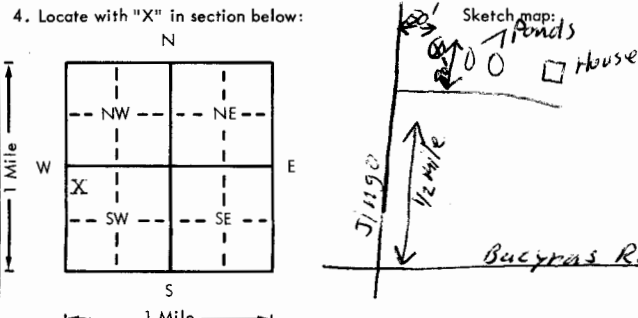
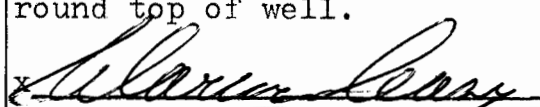


USE TYPEWRITER OR BALL POINT PEN-PRESS FIRMLY, PRINT CLEARLY.

WATER WELL RECORD
KSA 82a-1201-1215

Kansas Department of Health and Environment-Division of Environment
(Water well Contractors)
Topeka, Kansas 66620

1. Location of well: County MIAMI MIAAMI		Fraction NW NW/4 SW/4		Section number 19	Township number T 15 S R 25	Range number 25	E 100
2. Distance and direction from nearest town or city: 1 Mile East of Bucyrus KS Street address of well location if in city:				3. Owner of well: Clarence Casey R.R. or street: Rt. 1 Bx. 118 City, state, zip code: Bucyrus, Kansas 66013			
4. Locate with "X" in section below: 				6. Bore hole dia: 8" in. Completion date 5/77 Well depth 380 ft.			
				7. <input type="checkbox"/> Cable tool <input checked="" type="checkbox"/> Rotary <input type="checkbox"/> Driven <input type="checkbox"/> Dug <input type="checkbox"/> Hollow rod <input type="checkbox"/> Jetted <input type="checkbox"/> Bored <input type="checkbox"/> Reverse rotary			
				8. Use: <input type="checkbox"/> Domestic <input type="checkbox"/> Public supply <input type="checkbox"/> Industry <input type="checkbox"/> Irrigation <input type="checkbox"/> Air conditioning <input type="checkbox"/> Stock <input checked="" type="checkbox"/> DRY HOLE <input type="checkbox"/> Oil field water <input type="checkbox"/> Other			
				9. Casing: Material <input type="checkbox"/> Height: Above or below Threaded <input type="checkbox"/> Welded <input type="checkbox"/> DRY HOLE <input type="checkbox"/> in. RMP <input type="checkbox"/> PVC <input type="checkbox"/> Weight <input type="checkbox"/> lbs./ft. Dia. <input type="checkbox"/> in. to <input type="checkbox"/> ft. depth Wall Thickness: inches or Dia. <input type="checkbox"/> in. to <input type="checkbox"/> ft. depth gage No. <input type="checkbox"/>			
5. Type and color of material				From	To		
surface				0	3		
broken rock				3	4		
shale (grey)				4	6		
lime (soft at top, grey/white)				6	27		
shale (grey) (green in middle)				27	52		
lime (brown, white)				52	68		
shale (grey)				68	127		
lime (white)				127	134		
shale (grey)				134	137		
lime				137	150		
shale (grey)				150	161		
lime (brown)				161	176		
shale Grey				176	184		
sandstone (grey)				184	186		
shale (green, 1' streaked red @193')				186	202		
lime Grey				202	202 1/2		
shale Grey				202 1/2	203		
limw Grey				203	208		
shale (black @ top, blue-green below)				208	246		
lime (white)				246	256		
shale Gray				256	269		
lime white				269	286		
shale (slaty) (Use a second sheet if needed)				286	292		
18. Elevation: 1090' Topography: <input type="checkbox"/> Hill <input checked="" type="checkbox"/> Slope <input type="checkbox"/> Upland <input type="checkbox"/> Valley		19. Remarks: Customer is aware of State regulation and agrees to install a 4' square re-enforced concrete platform around top of well. 				20. Water well contractor's certification: This well was drilled under my jurisdiction and this report is true to the best of my knowledge and belief. P. E. YOUNG DRILLING CO. 240 Business name License No. Address 6355 Robinhood In. Signed P. Young Date 6-13-77 Authorized representative	

T 15 S R 25 E 100
1/4 1/4 1/4 1/4

Forward the white, blue and pink copies to the Department of Health and Environment

Form WWC-5

F. E. YOUNG DRILLING CO., INC.
6355 Robinhood Ln. 432-2772
Merriam, Kansas 66203

KANSAS WELL LOG CONTINUED

Casey
Rt. 1 Bx. 118
Bucyrus, Kansas 66013

<u>type and color of material</u>	<u>from</u>	<u>to</u>
lime <i>Grey</i>	292	324
slate <i>Black</i>	324	328
lime <i>Grey</i>	328	330
shale <i>Grey</i>	330	334
lime <i>white</i>	334	341
shale (green)	341	350
shale (red)	350	354
shale (grey)	354	364
sandstone <i>Brown</i>	364	366
shale (grey)	366	380

Total Depth 380'
Dry Hole-- Plugged