# WATER WELL PLUGGING RECORD Form WWC-5P KSA 82a-1212 ID NO.

**1 LOCATION OF WATER WELL:** County: Johnson | Fraction: ¼ ¼ ¼ ¼ | Section Number: 17 | Township Number: T 15 S | Range Number: 25 ☒ E ☐ W

Street/Rural Address of Well Location; if unknown, distance & direction from nearest town or intersection: If at owner's address, check here ☐ 20875 Metcalf Ave Bucyrus, Kansas

**Global Positioning Systems (GPS) information:**
Latitude: 38°46' 10" N (in decimal degrees)
Longitude: 94° 39' 4" W (in decimal degrees)
Elevation:
Datum: ☐ WGS84, ☐ NAD83, ☑ NAD27
Collection Method:
☒ GPS unit (Make/Model: I Phone 5s)
☐ Digital Map/Photo, ☐ Topographic Map, ☐ Land Survey
Est. Accuracy: ☐ <3 m, ☒ 3-5 m, ☐ 5-15 m, ☐ > 15 m

**2 WATER WELL OWNER:** Johnson Cty Public Works
RR#, St. Address, Box #: 1800 W 56th Hwy
City, State ZIP Code: Olathe KS 66061

**3 MARK WELL'S LOCATION WITH AN "X" IN SECTION BOX:**

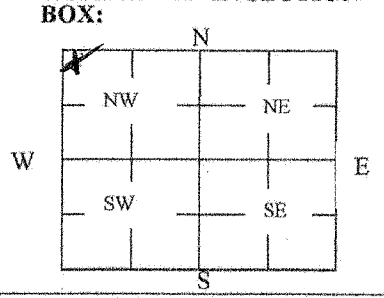


**4 DEPTH OF WELL** 19 ft.
WELL'S STATIC WATER LEVEL 4 ft
WELL WAS USED AS:

| | | | |
|---|---|---|---|
| ☒ Domestic | ☐ Public Water Supply | ☐ Dewatering | |
| ☐ Irrigation | ☐ Oil Field Water Supply | ☐ Monitoring | |
| ☐ Feedlot | ☐ Domestic (Lawn & Garden) | ☐ Injection Well | |
| ☐ Industrial | ☐ Air Conditioning | ☐ Other | |

Was a chemical/bacteriological sample submitted to Department? Yes ☐ No ☑

**5 TYPE OF BLANK CASING USED:**

| | | | | |
|---|---|---|---|---|
| ☐ Steel | ☐ RMP (SR) | ☐ Wrought | ☐ Fiberglass | ☐ Other (Specify below) |
| ☐ PVC | ☐ ABS | ☐ Asbestos-Cement | ☐ Concrete Tile | Brick |

Blank casing diameter 8 Ft in. Was casing pulled? Yes ☒ No ☐ If yes, how much 6 feet
Casing height above or below land surface 0 in.
* Excavated

**6 GROUT PLUG MATERIAL:** ☐ Neat cement ☐ Cement grout ☒ Bentonite ☐ Other

Grout Plug Intervals: From 4 ft. to 2 ft., From ____ ft. to ____ ft., From ____ ft. to ____ ft.

What is the nearest source of possible contamination:

| | | | |
|---|---|---|---|
| ☒ Septic tank | ☐ Seepage pit | ☐ Fuel storage | ☐ Other (specify below) |
| ☐ Sewer lines | ☐ Pit privy | ☐ Fertilizer storage | |
| ☐ Watertight sewer lines | ☐ Sewage lagoon | ☐ Insecticide storage | |
| ☐ Lateral lines | ☐ Feedyard | ☐ Abandoned water well | Direction from well? |
| ☐ Cess pool | ☐ Livestock pens | ☐ Oil well/Gas well | How many feet? |

| FROM | TO | PLUGGING MATERIALS | FROM | TO | PLUGGING MATERIALS |
|---|---|---|---|---|---|
| 19 | 4 | AB-3 gravel | | | |
| 4 | 2 | Bentonite | | | |
| 2 | 0 | Soil | | | |
| | | | | | |
| | | | | | |
| | | | | | |
| | | | | | |

**7 CONTRACTOR'S OR LANDOWNER'S CERTIFICATION:** This water well was plugged under my jurisdiction and was completed on (mo/day/year) 10/24/13 and this record is true to the best of my knowledge and belief. Kansas Water Well Contractor's License No. 650. This Water Well Record was completed on (mo/day/year) 10/29/13 under the business name of PetroCon, Inc by (signature)

**INSTRUCTIONS:** Use typewriter or ballpoint pen. Please press firmly and print clearly. Please fill in blanks, underline or circle the correct answers. Send top three copies to Kansas Department of Health and Environment, Bureau of Water, Geology Section, 1000 SW Jackson St., Ste. 420, Topeka, Kansas 66612-1367. Telephone: 785/296-5524. Send one to Water Well Owner and retain one for your records. Visit us at http://www.kdheks.gov/waterwell/index.html.