


1 LOCATION OF WATER WELL: County: Dickinson Fraction: NW 1/4 NW 1/4 SW 1/4 Section Number: 11 Township Number: T 15 S Range Number: R 3 E/W

Distance and direction from nearest town or city street address of well if located within city?

4 1/2 N Hope

2 WATER WELL OWNER: Tom Rock
 RR#, St. Address, Box #: RR1
 City, State, ZIP Code: Hope, KS. 67451
 Board of Agriculture, Division of Water Resources
 Application Number:

3 LOCATE WELL'S LOCATION WITH AN "X" IN SECTION BOX:

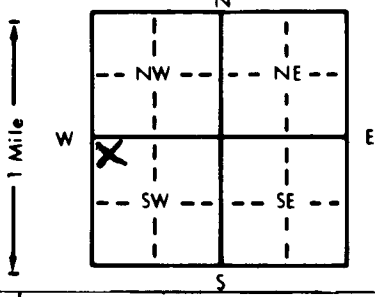

4 DEPTH OF COMPLETED WELL: 61 ft. ELEVATION:

Depth(s) Groundwater Encountered: 1. 31 ft. 2. 51 ft. 3. 4-19-91 ft.
 WELL'S STATIC WATER LEVEL: 32 ft. below land surface measured on mo/day/yr


WELL WATER TO BE USED AS:
 1 Domestic 1 3 Feedlot 0 6 Oil field water supply 0 9 Dewatering 0 12 Other (Specify below)
 2 Irrigation 0 4 Industrial 0 7 Lawn and garden only 0 10 Monitoring well 0

Was a chemical/bacteriological sample submitted to Department? Yes X No 0; If yes, mo/day/yr sample was submitted
 Water Well Disinfected? Yes X No 0

5 TYPE OF BLANK CASING USED:
 1 Steel 0 3 RMP (SR) 0 5 Wrought iron 0 8 Concrete tile 0 CASING JOINTS: Glued X Clamped 0
 2 PVC 5 4 ABS 45 6 Asbestos-Cement 0 9 Other (specify below) 0 Welded 0
 7 Fiberglass 0 Threaded 0

Blank casing diameter: 5 in. to 45 ft., Dia. 12 in. to 160 lbs./ft. Wall thickness or gauge No. 214

TYPE OF SCREEN OR PERFORATION MATERIAL:
 1 Steel 0 3 Stainless steel 0 5 Fiberglass 0 8 RMP (SR) 0 10 Asbestos-cement 0
 2 Brass 0 4 Galvanized steel 0 6 Concrete tile 0 9 ABS 0 11 Other (specify) 0
 12 None used (open hole) 0

SCREEN OR PERFORATION OPENINGS ARE:
 1 Continuous slot 0 3 Mill slot 0 5 Gauzed wrapped 0 8 Saw cut 0 11 None (open hole) 0
 2 Louvered shutter 0 4 Key punched 0 6 Wire wrapped 0 9 Drilled holes 0
 7 Torch cut 0 10 Other (specify) 0

SCREEN-PERFORATED INTERVALS: From 45 ft. to 61 ft., From 0 ft. to 0 ft.
 GRAVEL PACK INTERVALS: From 20 ft. to 61 ft., From 0 ft. to 0 ft.

6 GROUT MATERIAL: 1 Neat cement 0 2 Cement grout 20 3 Bentonite 0 4 Other 0
 Grout Intervals: From 0 ft. to 20 ft., From 0 ft. to 0 ft.

What is the nearest source of possible contamination:
 1 Septic tank 0 4 Lateral lines 0 7 Pit privy 0 10 Livestock pens 0 14 Abandoned water well 0
 2 Sewer lines 0 5 Cess pool 0 8 Sewage lagoon 0 11 Fuel storage 0 15 Oil well/Gas well 0
 3 Watertight sewer lines 0 6 Seepage pit 0 9 Feedyard 0 12 Fertilizer storage 0 16 Other (specify below) 0
 13 Insecticide storage 0

Direction from well? W How many feet? 100 +

FROM	TO	LITHOLOGIC LOG	FROM	TO	PLUGGING INTERVALS
0	32	Yellow Clay			
32	41	Blue Shale			
41	46	Red Shale			
46	51	Gray Shale			
51	52	Water			
52	61	Gray Rock			

7 CONTRACTOR'S OR LANDOWNER'S CERTIFICATION: This water well was (1) constructed, (2) reconstructed, or (3) plugged under my jurisdiction and was completed on (mo/day/year) 4-18-91 and this record is true to the best of my knowledge and belief. Kansas Water Well Contractor's License No. 120 This Water Well Record was completed on (mo/day/yr) 4-20-91 under the business name of Backhoe Drilling by (signature) [Signature]