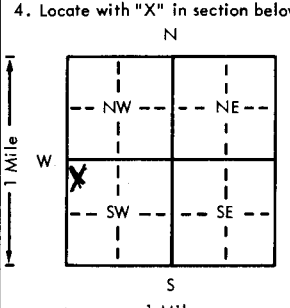


USE TYPEWRITER OR BALL POINT PEN-PRESS FIRMLY, PRINT CLEARLY.

WATER WELL RECORD
KSA 820-1201-1215

Kansas Department of Health and Environment-Division of Environment
(Water well Contractors)
Topeka, Kansas 66620

1. Location of well: County <u>Dickinson</u> Fraction <u>Nw 1/4 Nw 1/4 Sw 1/4</u> Section number <u>20</u> Township number <u>T 15 S</u> Range number <u>R 3 E</u>	
2. Distance and direction from nearest town or city: <u>3 W 2 1/2 N</u> Street address of well location if in city: <u>Hope</u> 3. Owner of well: <u>Phil Bryant</u> R.R. or street: <u>RRI</u> City, state, zip code: <u>Hope Mo. 67451</u>	
4. Locate with "X" in section below: Sketch map: 	
5. Type and color of material	
	From To
<u>Top Soil</u>	<u>0 1</u>
<u>lime Stone</u>	<u>1 3</u>
<u>yellow + Red clay</u>	<u>3 57</u>
<u>Water</u>	<u>57 58</u>
<u>yellow Shale</u>	<u>58 67</u>
<u>Blue Shale</u>	<u>67 68</u>
(Use a second sheet if needed)	
18. Elevation:	19. Remarks:
Topography: <input checked="" type="checkbox"/> Hill <input checked="" type="checkbox"/> Slope <input type="checkbox"/> Upland <input type="checkbox"/> Valley	20. Water well contractor's certification: This well was drilled under my jurisdiction and this report is true to the best of my knowledge and belief. <u>Bac Khus Drg. 180</u> Business name _____ License No. _____ Address <u>Tampa Mo.</u> Signed <u>Paul Baathus</u> Date <u>4-1-79</u> Authorized representative

6. Bore hole dia. <u>6 7/8</u> in. Completion date: <u>3-26-79</u> Well depth <u>68</u> ft.
7. <input checked="" type="checkbox"/> Cable tool <input type="checkbox"/> Rotary <input type="checkbox"/> Driven <input type="checkbox"/> Dug <input type="checkbox"/> Hollow rod <input type="checkbox"/> Jetted <input type="checkbox"/> Bored <input type="checkbox"/> Reverse rotary
8. Use: <input type="checkbox"/> Domestic <input type="checkbox"/> Public supply <input type="checkbox"/> Industry <input type="checkbox"/> Irrigation <input type="checkbox"/> Air conditioning <input checked="" type="checkbox"/> Stock <input type="checkbox"/> Lawn <input type="checkbox"/> Oil field water <input type="checkbox"/> Other
9. Casing: Material <u>Styrene</u> Weight: <u>10 wgt./ft.</u> Threading: <input type="checkbox"/> Threaded <input type="checkbox"/> Welded <input type="checkbox"/> Surface <u>92</u> in. RMP: <input type="checkbox"/> PVC <input type="checkbox"/> Weight: <u>10 wgt./ft.</u> Dia. <u>5</u> in. to <u>68</u> ft. depth Wall Thickness: inches or Dia. <u>5</u> in. to <u>68</u> ft. depth Gauge No. <u>200 wall</u>
10. Screen - Manufacturer's name <u>Cam-mac</u> Type <u>Styrene</u> Dia. <u>5 1/2</u> Slot/gauze <u>1/2</u> Length <u>10</u> Set between <u>50</u> ft. and <u>60</u> ft. Gravel pack? <input checked="" type="checkbox"/> Size range of material <u>5/8</u>
11. Static water level: <u>40</u> ft. below land surface Date <u>3-26-79</u> mo./day/yr.
12. Pumping level below land surfaces: ____ ft. after ____ hrs. pumping ____ g.p.m. ____ ft. after ____ hrs. pumping ____ g.p.m. Estimated maximum yield ____ g.p.m.
13. Water sample submitted: <input checked="" type="checkbox"/> Yes <input checked="" type="checkbox"/> No Date _____ mo./day/yr.
14. Well head completion: <u>12</u> inches above grade <input type="checkbox"/> Pitless adapter
15. Well grouted? <input checked="" type="checkbox"/> With: <input checked="" type="checkbox"/> Neat cement <input type="checkbox"/> Bentonite <input type="checkbox"/> Concrete Depth: From <u>0</u> ft. to <u>10</u> ft.
16. Nearest source of possible contamination: <u>House</u> ft. <u>50</u> Direction <u>N</u> Type <u>Correl</u> Well disinfected upon completion? <input checked="" type="checkbox"/> Yes <input type="checkbox"/> No
17. Pump: <input checked="" type="checkbox"/> Not installed Manufacturer's name _____ Model number _____ HP _____ Volts _____ Length of drop pipe _____ ft. capacity _____ g.p.m. Type: <input type="checkbox"/> Submersible <input type="checkbox"/> Turbine <input type="checkbox"/> Jet <input type="checkbox"/> Reciprocating <input type="checkbox"/> Centrifugal <input type="checkbox"/> Other

T 15 S R 3 E Sec 20 NW 1/4 SW 1/4