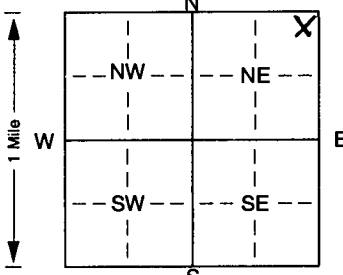


1 LOCATION OF WATER WELL: Fraction Me 1/4 Me 1/4 Me 1/4 Section Number 39 Township Number T 15 S Range Number R 3 E  
 County: Dickinson

Distance and direction from nearest town or city street address of well if located within city?  
1 N Hope

2 WATER WELL OWNER: Russel Walker  
 RR#, St. Address, Box #: 508 Paint Rd  
 City, State, ZIP Code: HOPE, KS, 67451  
 Board of Agriculture, Division of Water Resources  
 Application Number:

3 LOCATE WELL'S LOCATION WITH AN "X" IN SECTION BOX:  
  
 4 DEPTH OF COMPLETED WELL: 91 ft. ELEVATION: .....  
 Depth(s) Groundwater Encountered 1 ..... ft. 2. .... ft. 3. .... ft.  
 WELL'S STATIC WATER LEVEL 39 ..... ft. below land surface measured on mo/day/yr 5-12-01  
 Pump test data: Well water was ..... ft. after ..... hours pumping ..... gpm  
 Est. Yield 15-20 ..... gpm Well water was ..... ft. after ..... hours pumping ..... gpm  
 Bore Hole Diameter: 2 1/2 in. to 9 1/4 ..... ft., and ..... in. to ..... ft.  
 WELL WATER TO BE USED AS:  
 5 Public water supply 8 Air conditioning 11 Injection well  
 1 Domestic 3 Feedlot 6 Oil field water supply 9 Dewatering 12 Other (Specify below)  
 2 Irrigation 4 Industrial 7 Domestic (lawn & garden) 10 Monitoring well  
 Was a chemical/bacteriological sample submitted to Department? Yes. .... No. X; If yes, mo/day/yr sample was submitted  
 Water Well Disinfected? Yes X No

5 TYPE OF CASING USED:  
 1 Steel 3 RMP (SR) 5 Wrought iron 8 Concrete tile CASING JOINTS: Glued. X Clamped. ....  
 2 PVC 4 ABS 6 Asbestos-Cement 9 Other (specify below) Welded .....  
 7 Fiberglass Threaded. ....  
 Blank casing diameter 5 ..... in. to 7 0 ..... ft., Dia ..... in. to ..... ft.  
 Casing height above land surface 12 ..... in., weight CR 55160 ..... lbs./ft. Wall thickness or gauge No. 214  
 TYPE OF SCREEN OR PERFORATION MATERIAL:  
 1 Steel 3 Stainless steel 5 Fiberglass 8 RMP (SR) 10 Asbestos-cement  
 2 Brass 4 Galvanized steel 6 Concrete tile 9 ABS 11 Other (specify) .....  
 12 None used (open hole)  
 SCREEN OR PERFORATION OPENINGS ARE:  
 1 Continuous slot 3 Mill slot 5 Gauzed wrapped 8 Saw cut 11 None (open hole)  
 2 Louvered shutter 4 Key punched 6 Wire wrapped 9 Drilled holes  
 7 Torch cut 10 Other (specify) ..... ft.  
 SCREEN-PERFORATED INTERVALS: From 7 0 ..... ft. to 9 1 ..... ft., From ..... ft. to ..... ft.  
 GRAVEL PACK INTERVALS: From 2 2 ..... ft. to 9 1 ..... ft., From ..... ft. to ..... ft.

6 GROUT MATERIAL: 1 Neat cement 2 Cement grout 3 Bentonite 4 Other .....  
 Grout Intervals: From 0 ..... ft. to 22 ..... ft., From ..... ft. to ..... ft., From ..... ft. to ..... ft.  
 What is the nearest source of possible contamination:  
 1 Septic tank 4 Lateral lines 7 Pit privy 10 Livestock pens 14 Abandoned water well  
 2 Sewer lines 5 Cess pool 8 Sewage lagoon 11 Fuel storage 15 Oil well/Gas well  
 3 Watertight sewer lines 6 Seepage pit 9 Feedyard 12 Fertilizer storage 16 Other (specify below)  
 13 Insecticide storage .....  
 Direction from well? N How many feet? Will be 100-150'

FROM	TO	LITHOLOGIC LOG	FROM	TO	PLUGGING INTERVALS
<u>0</u>	<u>35</u>	<u>Yellow Clay</u>			
<u>35</u>	<u>37</u>	<u>Lime</u>			
<u>37</u>	<u>55</u>	<u>Yellow Clay mixed Shale</u>			
<u>55</u>	<u>75</u>	<u>Blue Shale</u>			
<u>75</u>	<u>76</u>	<u>Water</u>			
<u>76</u>	<u>91</u>	<u>Gray Shale</u>			

7 CONTRACTOR'S OR LANDOWNER'S CERTIFICATION: This water well was (1) constructed, (2) reconstructed, or (3) plugged under my jurisdiction and was completed on (mo/day/year) 5-12-01 ..... and this record is true to the best of my knowledge and belief. Kansas Water Well Contractor's Licence No. 120 ..... This Water Well Record was completed on (mo/day/yr) 5-15-01 ..... under the business name of Backhoe Drilling by (signature) Paul R. Backhoe