


1 LOCATION OF WATER WELL: County: Morris Fraction: SE 1/4 SE 1/4 SE 1/4 Section Number: 2 Township Number: T 15 S Range Number: R 5 EW

Distance and direction from nearest town or city street address of well if located within city?
5 west 13/4 South of White City

2 WATER WELL OWNER: Ronald Britt
RR#, St. Address, Box #: Rt 1
City, State, ZIP Code: White City, Kansas 66872
Board of Agriculture, Division of Water Resources
Application Number:

3 LOCATE WELL'S LOCATION WITH AN "X" IN SECTION BOX:

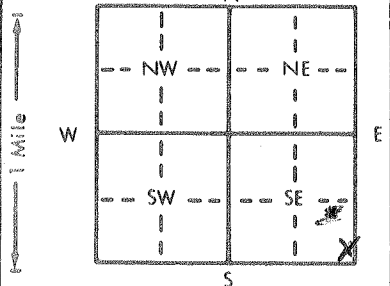

4 DEPTH OF COMPLETED WELL: 85 ft. ELEVATION:

Depth(s) Groundwater Encountered 1. 72 ft. 2. ft. 3. ft.
WELL'S STATIC WATER LEVEL 70 ft. below land surface measured on mo/day/yr Sep 21 87
Pump test data: Well water was ft. after hours pumping gpm
Est. Yield 9 gpm Well water was ft. after hours pumping gpm
Bore Hole Diameter 8 in. to 23 ft., and 6 1/2 in. to 85 ft.
WELL WATER TO BE USED AS: 5 Public water supply 8 Air conditioning 11 Injection well
① Domestic 3 Feedlot 6 Oil field water supply 9 Dewatering 12 Other (Specify below)
2 Irrigation 4 Industrial 7 Lawn and garden only 10 Monitoring well
Was a chemical/bacteriological sample submitted to Department? Yes.....No X.....; If yes, mo/day/yr sample was submitted
Water Well Disinfected? Yes No

5 TYPE OF BLANK CASING USED: 1 Steel 3 RMP (SR) 5 Wrought iron 8 Concrete tile CASING JOINTS: Glued X Clamped
② PVC 4 ABS 6 Asbestos-Cement 9 Other (specify below) Welded
7 Fiberglass Threaded

Blank casing diameter 5 in. to 70 ft., Dia. in. to ft., Dia. in. to ft.
Casing height above land surface 16 in., weight lbs./ft. Wall thickness or gauge No. SDR-26

TYPE OF SCREEN OR PERFORATION MATERIAL: 1 Steel 3 Stainless steel 5 Fiberglass 7 PVC 10 Asbestos-cement
2 Brass 4 Galvanized steel 6 Concrete tile 8 RMP (SR) 11 Other (specify)
9 ABS 12 None used (open hole)

SCREEN OR PERFORATION OPENINGS ARE: 1 Continuous slot 3 Mill slot 5 Gauzed wrapped ⑧ Saw cut 11 None (open hole)
2 Louvered shutter 4 Key punched 6 Wire wrapped 9 Drilled holes
7 Torch cut 10 Other (specify)

SCREEN-PERFORATED INTERVALS: From 70 ft. to 85 ft., From ft. to ft.
From ft. to ft., From ft. to ft.
GRAVEL PACK INTERVALS: From NONE ft. to ft., From ft. to ft.
From ft. to ft., From ft. to ft.

6 GROUT MATERIAL: ① Neat cement 2 Cement grout 3 Bentonite 4 Other
Grout Intervals: From 3 ft. to 23 ft., From ft. to ft., From ft. to ft.

What is the nearest source of possible contamination:
1 Septic tank 4 Lateral lines 7 Pit privy ⑩ Livestock pens 14 Abandoned water well
2 Sewer lines 5 Cess pool 8 Sewage lagoon 11 Fuel storage 15 Oil well/Gas well
3 Watertight sewer lines 6 Seepage pit 9 Feedyard 12 Fertilizer storage 16 Other (specify below)
13 Insecticide storage

Direction from well? South How many feet? 50

FROM	TO	LITHOLOGIC LOG	FROM	TO	PLUGGING INTERVALS
0	3	Topsoil			
3	10	LIME lite			
10	12	Shale Yel			
12	15	LIME Yel			
15	27	Shale Yel			
27	30	LIME Yel			
30	42	Shale lite Gray			
42	52	Shale lite			
52	69	Red Rock			
69	78	LIME Frac lite TAN			
78	79	LIME Solid lite TAN			
78	80	Shale lite TAN			
80	84	LIME lite TAN			
84	85	Shale lite Gray			

7 CONTRACTOR'S OR LANDOWNER'S CERTIFICATION: This water well was ① constructed, (2) reconstructed, or (3) plugged under my jurisdiction and was completed on (mo/day/year) Sep 21 87 and this record is true to the best of my knowledge and belief. Kansas Water Well Contractor's License No. 218 This Water Well Record was completed on (mo/day/yr) Sep 30 87 under the business name of Zinn Water Well Dring by (signature) Joseph A. Zinn