


1 LOCATION OF WATER WELL: County: Morris Fraction: SE 1/4 SE 1/4 SE 1/4 Section Number: 5 Township Number: T 15S Range Number: R 5E

Distance and direction from nearest town or city street address of well if located within city?
7 North on US 77 - 2 East from Herington

2 WATER WELL OWNER: Fred Traskowsky
 RR#, St. Address, Box #: Rt 1 Box 3 Board of Agriculture, Division of Water Resources
 City, State, ZIP Code: Woodbine, KS 67492 Application Number:

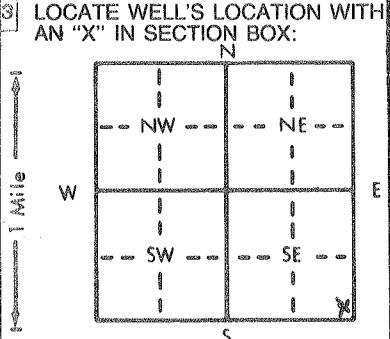

4 DEPTH OF COMPLETED WELL: 115 ft. ELEVATION: _____ ft.
 Depth(s) Groundwater Encountered 1. 106 ft. 2. _____ ft. 3. _____ ft.
 WELL'S STATIC WATER LEVEL: 91 ft. below land surface measured on mo/day/yr Mar. 8, 88
 Pump test data: Well water was _____ ft. after _____ hours pumping _____ gpm
 Est. Yield 10 gpm: Well water was _____ ft. after _____ hours pumping _____ gpm
 Bore Hole Diameter: 8 in. to 2 1/2 ft., and 6 1/2 in. to 115 ft.
 WELL WATER TO BE USED AS:
 Domestic Feedlot Oil field water supply Air conditioning Injection well
 Irrigation Industrial Lawn and garden only Dewatering Monitoring well
 Was a chemical/bacteriological sample submitted to Department? Yes _____ No If yes, mo/day/yr sample was submitted _____
 Water Well Disinfected? Yes No

5 TYPE OF BLANK CASING USED:
 1 Steel 3 RMP (SR) 5 Wrought iron 8 Concrete tile CASING JOINTS: Glued Clamped
 2 PVC 4 ABS 7 Fiberglass 9 Other (specify below) Welded
 Blank casing diameter: 5 in. to 90 ft., Dia _____ in. to _____ ft., Dia _____ in. to _____ ft.
 Casing height above land surface: 16 in., weight _____ lbs./ft. Wall thickness or gauge No. SDR 26
 TYPE OF SCREEN OR PERFORATION MATERIAL:
 1 Steel 3 Stainless steel 5 Fiberglass 8 RMP (SR) 10 Asbestos-cement
 2 Brass 4 Galvanized steel 6 Concrete tile 9 ABS 11 Other (specify) _____
 12 None used (open hole)
 SCREEN OR PERFORATION OPENINGS ARE:
 1 Continuous slot 3 Mill slot 5 Gauzed wrapped 8 Saw cut 11 None (open hole)
 2 Louvered shutter 4 Key punched 6 Wire wrapped 9 Drilled holes
 7 Torch cut 10 Other (specify) _____
 SCREEN-PERFORATED INTERVALS: From 90 ft. to 115 ft., From _____ ft. to _____ ft.
 GRAVEL PACK INTERVALS: From NONE ft. to _____ ft., From _____ ft. to _____ ft.

6 GROUT MATERIAL: 1 Neat cement 2 Cement grout 3 Bentonite 4 Other _____
 Grout Intervals: From 3 ft. to 24 ft., From _____ ft. to _____ ft., From _____ ft. to _____ ft.
 What is the nearest source of possible contamination:
 1 Septic tank 4 Lateral lines 7 Pit privy 10 Livestock pens 14 Abandoned water well
 2 Sewer lines 5 Cess pool 8 Sewage lagoon 11 Fuel storage 15 Oil well/Gas well
 3 Watertight sewer lines 6 Seepage pit 9 Feedyard 12 Fertilizer storage 16 Other (specify below) Barn Yard
 13 Insecticide storage
 Direction from well? North Down Slope How many feet? 50

FROM	TO	LITHOLOGIC LOG	FROM	TO	PLUGGING INTERVALS
0	2	Topsoil	111	114	LIME Solid TAN
2	6	Clay Brn.	114	115	Shale Gray
6	15	Red Rock			
15	25	Shale Lite Gray			
25	28	LIME TAN			
28	29	Shale Brn			
29	40	LIME TAN / Flint			
40	45.5	Shale Brn			
45.5	52	LIME TAN			
52	54	Shale Yel			
54	56	LIME Lite			
56	98	Shale Red-Yel-Green			
98	104	LIME Soft TAN			
104	106	Shale Lite Gray			
106	111	LIME TAN Frac / Shale			

7 CONTRACTOR'S OR LANDOWNER'S CERTIFICATION: This water well was (1) constructed, (2) reconstructed, or (3) plugged under my jurisdiction and was completed on (mo/day/year) Mar. 8, 89 and this record is true to the best of my knowledge and belief. Kansas Water Well Contractor's License No. 218 This Water Well Record was completed on (mo/day/yr) May 15, 88 under the business name of Zinn Water Well Drlg by (signature) Joseph A. Zinn