


1 LOCATION OF WATER WELL: *Morris*
 County: ~~Dickinson~~ *Se 1/4 Se 1/4 Sw 1/4* Section Number *31* Township Number *T 15 S* Range Number *R 5 E*

Distance and direction from nearest town or city street address of well if located within city?

2 1/2 N 1/2 E Herington

2 WATER WELL OWNER: *Orvaischlesenen*
 RR#, St. Address, Box #: *BRI* Board of Agriculture, Division of Water Resources
 City, State, ZIP Code: *Hope, KS. 67451* Application Number:

3 LOCATE WELL'S LOCATION WITH AN "X" IN SECTION BOX: 4 DEPTH OF COMPLETED WELL: *207.5* ft. ELEVATION: *11-14-90*

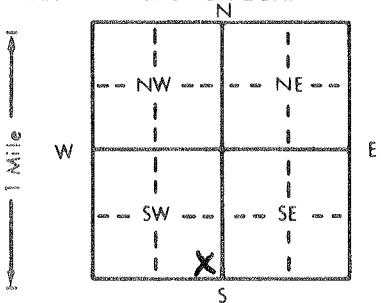

Depth(s) Groundwater Encountered 1. *53* ft. 2. *207.5* ft. 3. *11-14-90* ft.
 WELL'S STATIC WATER LEVEL *53* ft. below land surface measured on mo/day/yr *11-14-90*
 Pump test data: Well water was _____ ft. after _____ hours pumping _____ gpm
 Est. Yield *20* gpm; Well water was _____ ft. after _____ hours pumping _____ gpm
 Bore Hole Diameter: *1 1/2* in. to *20* ft., and *6* in. to *20* ft.
 WELL WATER TO BE USED AS:
 1 Domestic 3 Feedlot 6 Oil field water supply 9 Dewatering 12 Other (Specify below)
 2 Irrigation 4 Industrial 7 Lawn and garden only 10 Monitoring well
 Was a chemical/bacteriological sample submitted to Department? Yes _____ No X; If yes, mo/day/yr sample was submitted _____
 Water Well Disinfected? Yes X No

5 TYPE OF BLANK CASING USED:
 1 Steel 3 RMP (SR) 5 Wrought iron 8 Concrete tile CASING JOINTS: Glued X Clamped _____
 2 PVC 4 ABS 6 Asbestos-Cement 9 Other (specify below) Welded _____
 7 Fiberglass Threaded _____
 Blank casing diameter *5* in. to *63* ft., Dia _____ in. to _____ ft., Dia _____ in. to _____ ft.
 Casing height above land surface *12* in., weight *CLASS 160* lbs./ft. Wall thickness or gauge No. *214*

TYPE OF SCREEN OR PERFORATION MATERIAL:
 1 Steel 3 Stainless steel 5 Fiberglass 7 PVC 10 Asbestos-cement
 2 Brass 4 Galvanized steel 6 Concrete tile 8 RMP (SR) 11 Other (specify) _____
 9 ABS 12 None used (open hole)

SCREEN OR PERFORATION OPENINGS ARE:
 1 Continuous slot 3 Mill slot 5 Gauzed wrapped 8 Saw cut 11 None (open hole)
 2 Louvered shutter 4 Key punched 6 Wire wrapped 9 Drilled holes
 7 Torch cut 10 Other (specify) _____

SCREEN-PERFORATED INTERVALS: From *63* ft. to *20* ft., From _____ ft. to _____ ft.
 From _____ ft. to _____ ft., From _____ ft. to _____ ft.
 GRAVEL PACK INTERVALS: From *20* ft. to *20* ft., From _____ ft. to _____ ft.
 From _____ ft. to _____ ft., From _____ ft. to _____ ft.

6 GROUT MATERIAL: 1 Neat cement 2 Cement grout 3 Bentonite 4 Other _____
 Grout Intervals: From *0* ft. to *20* ft., From _____ ft. to _____ ft., From _____ ft. to _____ ft.

What is the nearest source of possible contamination:
 1 Septic tank 4 Lateral lines 7 Pit privy 10 Livestock pens 14 Abandoned water well
 2 Sewer lines 5 Cess pool 8 Sewage lagoon 11 Fuel storage 15 Oil well/Gas well
 3 Watertight sewer lines 6 Seepage pit 9 Feedyard 12 Fertilizer storage 16 Other (specify below)
 13 Insecticide storage *In Pasture for Cattle*

Direction from well? How many feet? *for Cattle*

FROM	TO	LITHOLOGIC LOG	FROM	TO	PLUGGING INTERVALS
		<i>Cleaned & Recased</i>			

7 CONTRACTOR'S OR LANDOWNER'S CERTIFICATION: This water well was (1) constructed, (2) reconstructed, or (3) plugged under my jurisdiction and was completed on (mo/day/year) *11-14-90* and this record is true to the best of my knowledge and belief. Kansas Water Well Contractor's License No. *180* This Water Well Record was completed on (mo/day/yr) *11-16-90* under the business name of *Backhus Drilling* by (signature) *Paul H. Backhus*