


1 LOCATION OF WATER WELL: County: Morris Fraction: NW 1/4 NE 1/4 SW 1/4 Section Number: 10 Township Number: T 15 S Range Number: R 5 E **(EW)**

Distance and direction from nearest town or city street address of well if located within city? MW-12

2 WATER WELL OWNER: KDHE - Forbes Field
 RR#, St. Address, Box #: Topeka, Ks Board of Agriculture, Division of Water Resources
 City, State, ZIP Code: Topeka, Ks Application Number:

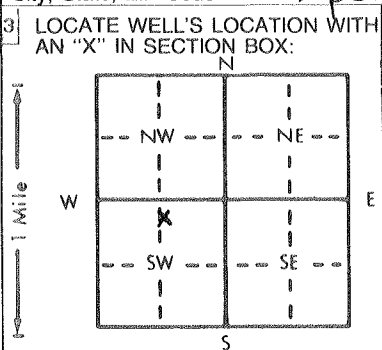

4 DEPTH OF COMPLETED WELL: 19.5 ft. ELEVATION: ± 1340
 Depth(s) Groundwater Encountered 1. ft. 2. ft. 3. ft.
 WELL'S STATIC WATER LEVEL ft. below land surface measured on mo/day/yr
 Pump test data: Well water was ft. after hours pumping gpm
 Est. Yield gpm; Well water was ft. after hours pumping gpm
 Bore Hole Diameter: 6 in. to 19.5 ft., and in. to ft.
 WELL WATER TO BE USED AS: 5 Public water supply 8 Air conditioning 11 Injection well
 1 Domestic 3 Feedlot 6 Oil field water supply 9 Dewatering 12 Other (Specify below)
 2 Irrigation 4 Industrial 7 Lawn and garden only **(10) Monitoring well**
 Was a chemical/bacteriological sample submitted to Department? Yes No **X**; If yes, mo/day/yr sample was sub-
 mitted Water Well Disinfected? Yes No **X**

5 TYPE OF BLANK CASING USED: 1 Steel 2 PVC **(2)** 3 RMP (SR) 4 ABS 5 Wrought iron 6 Asbestos-Cement 7 Fiberglass 8 Concrete tile 9 Other (specify below) CASING JOINTS: Glued Clamped Welded Threaded **X**
 Blank casing diameter 2 in. to 9.5 ft., Dia 24 in. to 69 in. to ft., Dia in. to ft.
 Casing height above land surface in., weight lbs./ft. Wall thickness or gauge No.
 TYPE OF SCREEN OR PERFORATION MATERIAL: 1 Steel 2 Brass 3 Stainless steel 4 Galvanized steel 5 Fiberglass 6 Concrete tile 7 PVC **(7)** 8 RMP (SR) 9 ABS 10 Asbestos-cement 11 Other (specify) 12 None used (open hole)
 SCREEN OR PERFORATION OPENINGS ARE: 1 Continuous slot 2 Louvered shutter 3 Mill slot **(3)** 4 Key punched 5 Gauzed wrapped 6 Wire wrapped 7 Torch cut 8 Saw cut 9 Drilled holes 10 Other (specify) 11 None (open hole)
 SCREEN-PERFORATED INTERVALS: From 9.5 ft. to 19.5 ft., From ft. to ft.
 GRAVEL PACK INTERVALS: From 7 ft. to 19.5 ft., From ft. to ft.

6 GROUT MATERIAL: 1 Neat cement **(1)** 2 Cement grout 3 Bentonite **(3)** 4 Other
 Grout Intervals: From 0 ft. to 3 ft., From 3 ft. to 7 ft., From ft. to ft.
 What is the nearest source of possible contamination: 1 Septic tank 2 Sewer lines 3 Watertight sewer lines 4 Lateral lines 5 Cess pool 6 Seepage pit 7 Pit privy 8 Sewage lagoon 9 Feedyard 10 Livestock pens 11 Fuel storage 12 Fertilizer storage 13 Insecticide storage 14 Abandoned water well 15 Oil well/Gas well 16 Other (specify below)
 Direction from well? unknown How many feet?

FROM	TO	LITHOLOGIC LOG	FROM	TO	PLUGGING INTERVALS
0	5	Top Soil			
5	15	Dk brn Clay			
15	17	Lt. brn Ls.			
17	18.5	Red Shale			

7 CONTRACTOR'S OR LANDOWNER'S CERTIFICATION: This water well was **(1)** constructed, (2) reconstructed, or (3) plugged under my jurisdiction and was completed on (mo/day/year) 6-23-98 and this record is true to the best of my knowledge and belief. Kansas Water Well Contractor's License No. 581 This Water Well Record was completed on (mo/day/year) 6-24-98 under the business name of Layne Western Co. by (signature) Oliver R. Mitchell