

CORRECTION(S) TO WATER WELL RECORD (WWC-5)

(to rectify lacking or incorrect information)

County: Morris

Location listed as:

Location ~~changed to:~~

Section-Township-Range: _____

31-155-6E

Fraction ($\frac{1}{4}$ $\frac{1}{4}$ $\frac{1}{4}$): _____

NE NW SW

Other changes: Initial statements: Dickinson County

Changed to: Morris County

Comments: _____

verification method: Written & legal descriptions, position on plat map, and Delavan 1:24,000 topo. map.

initials: DRJ date: 7/14/2005

submitted by: Kansas Geological Survey, Data Resources Library, 1930 Constant Ave., Lawrence, KS 66047-3726
to: Kansas Dept of Health & Environment, Bureau of Water, 1000 SW Jackson, Suite 420, Topeka, KS 66612-1367.


1 LOCATION OF WATER WELL. Fraction NE 1/4 NW 1/4 SW 1/4 Section 31 Township 15 Number 6 Range 6 Number 6

County: Dickinson

Distance and direction from nearest town or city street address of well if located within city?

7 miles east of Herington, KS on Hwy 56 to the Tri-County Airport

2 WATER WELL OWNER: Raytheon Aircraft Co.
9709 E Central
 RR #, St. Address, Box #: Wichita, KS 67201 Board of Agriculture, Division of Water Resources
 City, State, ZIP Code Application Number:

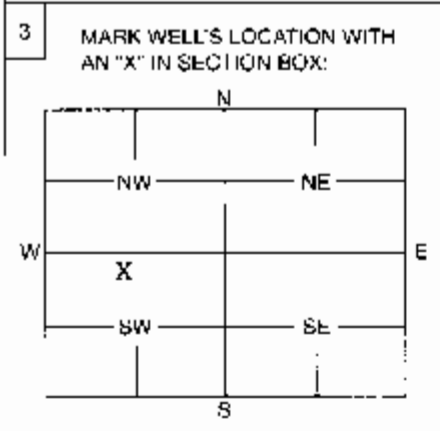

4 DEPTH OF WELL 64.10 ft.
 WELLS STATIC WATER LEVEL 62.8 ft.

WELL WAS USED AS

1 Domestic	5 Public Water Supply	8 Dewatering
2 Irrigation	6 Oil Field Water Supply	10 Monitoring Well
3 Foodlot	7 Domestic (Lawn & Garden)	11 Injection Well
4 Industrial	8 Air Conditioning	12 Other

Was a chemical / bacteriological sample submitted to Department? Yes No X
 If yes, (mo/day/yr) sample was submitted

Water Well Disinfected: Yes No X

5 TYPE OF BLANK CASING USED:

1 Steel	3 RMP (SR)	5 Wrought	7 Fiberglass	9 Other (Specify below)
2 PVC	4 ABS	6 Asbestos-Cement	8 Concrete Tile	

Blank casing diameter 2 in. Was casing pulled? Yes No X If yes, how much

Casing height above or below land surface -2 in.

6 GROUT PLUG MATERIAL: 1 Neat cement 2 Cement grout 3 Bentonite 4 Other

Grout Plug Intervals: From 64.10 ft. to 0 ft. From ft. to ft. From ft. to ft.

What is the nearest source of possible contamination

1 Septic tank	6 Seepage pit	11 Fuel storage	16 Other (specify below)
2 Sewer lines	7 Pit privy	12 Fertilizer storage	<u>Immediate Vicinity</u>
3 Watertight sewer lines	8 Sewage lagoon	13 Insecticide storage	
4 Lateral lines	9 Feedyard	14 Abandoned water well	
5 Cess pool	10 Livestock pens	15 Oil well/Gas well	

Direction from well? How many feet?

FROM	TO	PLUGGING MATERIALS
<u>64.10</u>	<u>0</u>	<u>Urethane pipe grouted from the bottom to surface.</u>

MW # 12

NOTE: At present time the wells are plugged. In the near future the /// well will be excavated to approx. depth of 13 ft. bgs.

7 CONTRACTOR'S OR LANDOWNER'S CERTIFICATION: This water well was plugged under my jurisdiction and was completed on (mo/day/year) 6/9/05 and this record is true to the best of my knowledge and belief. Kansas Water Well Contractor's License No. 665 This Water Well Record was completed on (mo/day/year) 6/14/05 Under the business name of Pratt Well Environmental by (signature) [Signature]

INSTRUCTIONS: Use typewriter or ball point pen. Please press firmly and print clearly. Please fill in blanks, underline or circle the correct answers. Send top three copies to Kansas Department of Health and Environment, Bureau of Water, Geology Section, 1000 SW Jackson St., Ste. 420, Topeka, Kansas 66612-1367. Telephone: 785-296-5522 Send one to Water Well Owner and retain one for your records.