

CORRECTION(S) TO WATER WELL RECORD (WWC-5)  
(to rectify lacking or incorrect information)

Location listed as:

Section-Township-Range: \_\_\_\_\_

Fraction (  $\frac{1}{4}$   $\frac{1}{4}$   $\frac{1}{4}$ ): \_\_\_\_\_

County: MORRIS

Location ~~changed to:~~

31-155-6E

NE NW SW

Other changes: Initial statements: Dickinson County

Changed to: Morris County

Comments: \_\_\_\_\_

verification method: Written & legal descriptions, position on plat map,  
and Delavan 1:24,000 topo. map.


initials: RR date: 7/14/2005

submitted by: Kansas Geological Survey, Data Resources Library, 1930 Constant Ave., Lawrence, KS 66047-3726  
to: Kansas Dept of Health & Environment, Bureau of Water, 1000 SW Jackson, Suite 420, Topeka, KS 66612-1367.

1	LOCATION OF WATER WELL:	Fraction	Section Number	Township Number	Range Number
	County: <u>Dickinson</u>	<u>NE 1/4 NW 1/4 SW 1/4</u>	<u>31</u>	<u>15</u>	<u>6</u> <b>(EW)</b>

Distance and direction from nearest town or city street address of well if located within city?  
**7 miles east of Herington, ks on Hwy 56 then north to Tri-County Airport.**

2 WATER WELL OWNER: Raytheon Aircraft Co.  
9709 E Central  
 RR #, St. Address, Box #: Wichita, KS 67201  
 City, State, ZIP Code :  
 Board of Agriculture, Division of Water Resources  
 Application Number:

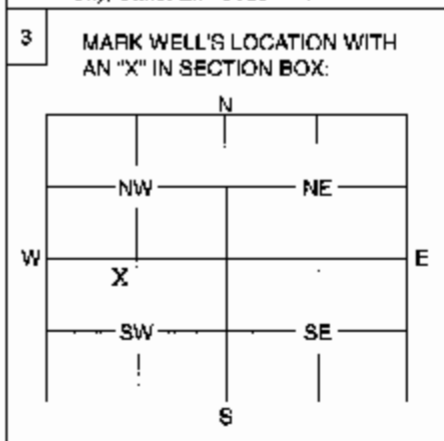

4 DEPTH OF WELL 65.28 ft.  
 WELL'S STATIC WATER LEVEL 60.50 ft.  
 WELL WAS USED AS:  
 1 Domestic 5 Public Water Supply 9 Dewatering  
 2 Irrigation 6 Oil Field Water Supply 10 Monitoring Well  
 3 Feedlot 7 Domestic (Lawn & Garden) 11 Injection Well  
 4 Industrial 8 Air Conditioning 12 Other  
 Was a chemical / bacteriological sample submitted to Department? Yes No **X**  
 If yes, mo/day/yr sample was submitted  
 Water Well Disinfected: Yes No **X**

5 TYPE OF BLANK CASING USED:  
 1 Steel 3 RMP (SR) 5 Wrought 7 Fiberglass 9 Other (Specify below)  
**2 PVC** 4 ABS 6 Asbestos-Cement 8 Concrete Tile  
 Blank casing diameter 2 in. Was casing pulled? Yes No **X** If yes, how much  
 Casing height above or below land surface 30 in.

6 GROUT PLUG MATERIAL: 1 Neat cement 2 Cement grout **3 Bentonite** 4 Other  
 Grout Plug Intervals: From 65.28 ft. to 30" N From .....ft. to .....ft. From ..... to .....ft.  
 What is the nearest source of possible contamination: **abgs**  
 1 Septic tank 6 Seepage pit 11 Fuel storage 16 Other (specify below) **Immediate Vicinity**  
 2 Sewer lines 7 Pit privy 12 Fertilizer storage  
 3 Wateright sewer lines 8 Sewage lagoon 13 Insecticide storage  
 4 Lateral lines 9 Feedyard 14 Abandoned water well  
 5 Cess pool 10 Livestock pens 15 Oil well/Gas well  
 Direction from well? 999 How many feet? 999

FROM	TO	PLUGGING MATERIALS
<u>65.28</u>	<u>+ 30"</u>	<u>Above ground surface tremie grouted from bottom to ags 30".</u>

**MW # 44**  
 NOTE: At present time the well is plugged. In the near future the well will be excavated to a depth of 6 ft BGS.

7 CONTRACTOR'S OF LANDOWNER'S CERTIFICATION: This water well was plugged under my jurisdiction and was completed on (mo/day/year) 6/9/05 and this record is true to the best of my knowledge and belief. Kansas Water Well Contractor's License No. 665 This Water Well Record was completed on (mo/day/year) 6/14/05 under the business name of Pratt Well Environmental by (signature) [Signature]

INSTRUCTIONS: Use typewriter or ball point pen. Please press firmly and print clearly. Please fill in blanks, underline or circle the correct answers. Send top three copies to Kansas Department of Health and Environment, Bureau of Water, Geology Section, 1000 SW Jackson St., Ste. 420, Topeka, Kansas 66612-1367. Telephone: 785/296-5522. Send one to Water Well Owner and retain one for your records.