

CORRECTION(S) TO WATER WELL RECORD (WWC-5)
(to rectify lacking or incorrect information)

Location listed as:

Section-Township-Range: _____

Fraction ($\frac{1}{4}$ $\frac{1}{4}$ $\frac{1}{4}$): _____

County: MORRIS

Location ~~changed to:~~

31-155-6E

NE NW SW

Other changes: Initial statements: Dickinson County

Changed to: Morris County

Comments: _____

verification method: Written & legal descriptions, position on plat map,
and Delavan 1:24,000 topo. map.


initials: ORL date: 7/14/2005

submitted by: Kansas Geological Survey, Data Resources Library, 1930 Constant Ave., Lawrence, KS 66047-3726
to: Kansas Dept of Health & Environment, Bureau of Water, 1000 SW Jackson, Suite 420, Topeka, KS 66612-1367.

1 LOCATION OF WATER WELL: Fraction Section Number Township Number Range Number
 County: Dickinson N04 NW 4SW 4 31 15 6 (EAV)

Distance and direction from nearest town or city street address of well if located within city?
 7 Miles east of Berington, KS on Hwy 56 to the Tri-County Airport & // 3 North

2 WATER WELL OWNER: Raytheon Aircraft Co.
 9709 E Central
 RR #, St. Address, Box #: Wichita, KS 67201
 City, State, ZIP Code :
 Board of Agriculture, Division of Water Resources
 Application Number:

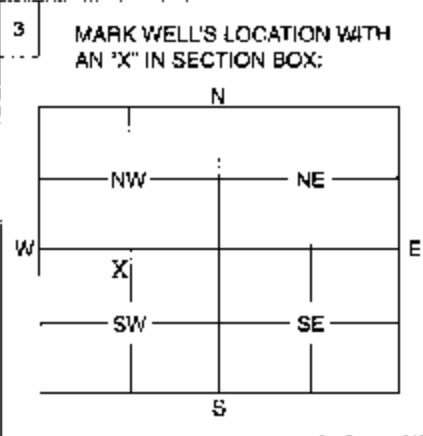

4 DEPTH OF WELL 79 ft.
 WELL'S STATIC WATER LEVEL 67 ft. (and rising)
 WELL WAS USED AS:
 1 Domestic 2 Irrigation 3 Feedlot 4 Industrial 5 Public Water Supply 6 Oil Field Water Supply 7 Domestic (Lawn & Garden) 8 Air Conditioning 9 Dewatering 10 Monitoring Well 11 Injection Well 12 Other
 Was a chemical / bacteriological sample submitted to Department? Yes No X
 If yes, mo/day/yr sample was submitted
 Water Well Disinfected: Yes No X

5 TYPE OF BLANK CASING USED:
 1 Steel 2 PVC 3 RMP (SR) 4 ABS 5 Wrought 6 Asbestos-Cement 7 Fiberglass 8 Concrete Tile 9 Other (Specify below)
 Blank casing diameter 2 in Was casing pulled? Yes No X If yes, how much
 Casing height above or below land surface 2 in

6 GROUT PLUG MATERIAL: 1 Neat cement 2 Cement grout 3 Bentonite 4 Other
 Grout Plug Intervals: From 79 ft. to -2" ft. From ft. to ft. From ft. to ft.
 What is the nearest source of possible contamination:
 1 Septic tank 2 Sewer lines 3 Watertight sewer lines 4 Lateral lines 5 Cess pool 6 Scepage pit 7 Pit privy 8 Sewage lagoon 9 Feedyard 10 Livestock pens 11 Fuel storage 12 Fertilizer storage 13 Insecticide storage 14 Abandoned water well 15 Oil well/Gas well 16 Other (specify below) Immediate Vicinity
 Direction from well? 999 How many feet? 999

FROM	TO	PLUGGING MATERIALS
79	-2"	Tremie pipe Bentonite grout from bottom to surface.

MW # 12A
 NOTE: At present time the wells are plugged. In the near future the well will be excavated to a depth of 13 ft BGS.

7 CONTRACTOR'S OF LANDOWNER'S CERTIFICATION: This water well was plugged under my jurisdiction and was completed on (mo/day/year) 6/9/05 and this record is true to the best of my knowledge and belief. Kansas Water Well Contractor's License No. 11 665 This Water Well Record was completed on (mo/day/year) 6/14/05 under the business name of Pratt Well Environmental
 by (signature) [Signature]

INSTRUCTIONS: Use typewriter or ball point pen. Please press firmly and print clearly. Please fill in blanks, underline or circle the correct answers. Send top three copies to Kansas Department of Health and Environment, Bureau of Water, Geology Section, 1000 SW Jackson St., Ste. 420, Topeka, Kansas 66612-1367. Telephone: 785/296-5522. Send one to Water Well Owner and retain one for your records.