

CORRECTION(S) TO WATER WELL RECORD (WWC-5)

(to rectify lacking or incorrect information)

County: Morris

Location listed as:

Location changed to:

Section-Township-Range: _____

31-155-6EFraction ($\frac{1}{4}$ $\frac{1}{4}$ $\frac{1}{4}$): _____NE NW SWOther changes: Initial statements: Dickinson CountyChanged to: Morris County


Comments: _____

verification method: Written & legal descriptions, position on plat map,
and Delavan 1:24,000 topo. map.initials: DRJ date: 7/14/2005submitted by: Kansas Geological Survey, Data Resources Library, 1930 Constant Ave., Lawrence, KS 66047-3726
to: Kansas Dept of Health & Environment, Bureau of Water, 1000 SW Jackson, Suite 420, Topeka, KS 66612-1367.

1 LOCATION OF WATER WELL: Fraction Section Number Township Number Range Number
 County: Dickinson NE 1/4 NW 1/4 31 15 6 **(EW)**

Distance and direction from nearest town or city street address of well if located within city?
 7 Miles east of Herington, KS on Hwy 56 then North to Tri-County Airport.

2 WATER WELL OWNER: Raytheon Aircraft Co.
 9709 E Central
 RR #, St. Address, Box #: Wichita, KS 67201
 City, State, ZIP Code : Board of Agriculture, Division of Water Resources
 Application Number:

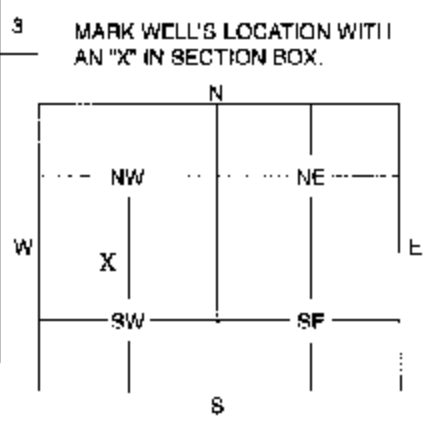

4 DEPTH OF WELL 79.6 ft.
 WELL'S STATIC WATER LEVEL 63.60 ft.
 WELL WAS USED AS:
 1 Domestic 2 Irrigation 3 Feedlot 4 Industrial 5 Public Water Supply 6 Oil Field Water Supply 7 Domestic (Lawn & Garden) 8 Air Conditioning 9 Dewatering 10 **(Monitoring Well)** 11 Injection Well 12 Other

Was a chemical / bacteriological sample submitted to Department? Yes No **X**
 If yes, mo/day/yr sample was submitted

Water Well Disinfected: Yes No **X**

5 TYPE OF BULK CASING USED:
 1 Steel 2 **(PVC)** 3 RMP (SR) 4 ABS 5 Winright 6 Astutelex-Cement 7 Fiberglass 8 Concrete Tile 9 Other (Specify below)

Blank casing diameter 2 in. Was casing pulled? Yes No **X** If yes, how much

Casing height above or below land surface 30 in.

6 GROUT PLUG MATERIAL: 1 Neat cement 2 Cement grout 3 **(Bentonite)** 4 Other

Grout Plug Intervals: From 79.6 ft. to 30 ft. / 1 in. From ft. to ft. From to ft.

What is the nearest source of possible contamination:
 1 Septic tank 2 Sewer lines 3 Watertight sewer lines 4 Lateral lines 5 Cess pool 6 Seepage pit 7 Pit privy 8 Sewage lagoon 9 Feedyard 10 Livestock pens 11 Fuel storage 12 Fertilizer storage 13 Insecticide storage 14 Abandoned water well 15 Oil well/Gas well 16 **(Other (specify below) Immediate Vicinity)**

Direction from well? 999 How many feet? 999

FROM	TO	PLUGGING MATERIALS
79.6	+ 30"	Above ground surface
		tremie pipe from bottom to top.

NOTE: At present time the well is plugged. In the near future the well will be excavated to a depth of 6 ft BGS.

7 CONTRACTOR'S OF LANDOWNER'S CERTIFICATION: This water well was plugged under my jurisdiction and was completed on (mo/day/year) 6/9/05 and this record is true to the best of my knowledge and belief. Kansas Water Well Contractor's License No. 665 This Water Well Record was completed on (mo/day/year) 6/14/05 under the business name of Pratt Well Environmental

by (signature) *Steven Gull*

INSTRUCTIONS: Use typewriter or ball point pen. Please press firmly and print clearly. Please fill in blanks, underline or circle the correct answers. Send top three copies to Kansas Department of Health and Environment, Bureau of Water, Geology Section, 1000 SW Jackson St., Ste. 420, Topeka, Kansas 66612-1367. Telephone: 785/296-6522. Send one to Water Well Owner and retain one for your records.