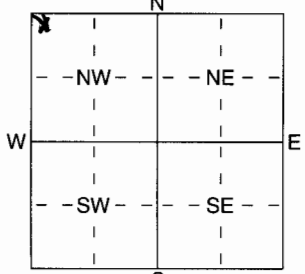


1 LOCATION OF WATER WELL: Fraction NW 1/4 NW 1/4 NW 1/4 Section Number 25 Township Number T 15 S Range Number R 6 E
 County: Morris

Distance and direction from nearest town or city street address of well if located within city?
5 South & 1 East of White City

2 WATER WELL OWNER: Jeany Britt
 RR#, St. Address, Box #: 1110 S 2100 Rd
 City, State, ZIP Code: White City, KS 66872
 Board of Agriculture, Division of Water Resources
 Application Number:

3 LOCATE WELL'S LOCATION WITH AN "X" IN SECTION BOX:

 4 DEPTH OF COMPLETED WELL 75 ft. ELEVATION: 60 ft.
 Depth(s) Groundwater Encountered 1 19 ft. 2 60 ft. 3 60 ft.
 WELL'S STATIC WATER LEVEL 19 ft. below land surface measured on mo/day/yr Sep 21 06
 Pump test data: Well water was _____ ft. after _____ hours pumping _____ gpm
 Est. Yield 20+ gpm: Well water was _____ ft. after _____ hours pumping _____ gpm
 WELL WATER TO BE USED AS:
 1 Domestic 3 Feedlot 6 Oil field water supply 9 Dewatering 12 Other (Specify below)
 2 Irrigation 4 Industrial 7 Domestic (lawn & garden) 10 Monitoring well
 Was a chemical/bacteriological sample submitted to Department? Yes _____ No ; If yes, mo/day/yr sample was submitted
 Water Well Disinfected Yes _____ No

5 TYPE OF BLANK CASING USED:
 1 Steel 3 RMP (SR) 5 Wrought iron 8 Concrete tile CASING JOINTS: Glued Clamped _____
 2 PVC 4 ABS 6 Asbestos-Cement 9 Other (specify below) Welded _____
 7 Fiberglass Threaded _____
 Blank casing diameter 5 in. to 40 ft., Dia _____ in. to _____ ft., Dia _____ in. to _____ ft.
 Casing height above land surface 18 in., weight _____ lbs./ft. Wall thickness or guage No. SDR 26
 TYPE OF SCREEN OR PERFORATION MATERIAL:
 1 Steel 3 Stainless Steel 5 Fiberglass 8 RMP (SR) 10 Asbestos-Cement
 2 Brass 4 Galvanized Steel 6 Concrete tile 9 ABS 11 Other (Specify) _____
 12 None used (open hole)
 SCREEN OR PERFORATION OPENINGS ARE:
 1 Continuous slot 3 Mill slot 5 Gauzed wrapped 8 Saw cut 11 None (open hole)
 2 Louvered shutter 4 Key punched 6 Wire wrapped 9 Drilled holes
 7 Torch cut 10 Other (specify) _____ ft.
 SCREEN-PERFORATED INTERVALS: From 40 ft. to 75 ft., From _____ ft. to _____ ft.
 GRAVEL PACK INTERVALS: From NONE ft. to _____ ft., From _____ ft. to _____ ft.
PACKER

6 GROUT MATERIAL: 1 Neat cement 2 Cement grout 3 Bentonite 4 Other _____
 Grout Intervals: From 3 ft. to 23 ft., From _____ ft. to _____ ft., From _____ ft. to _____ ft.
 What is the nearest source of possible contamination:
 1 Septic tank 4 Lateral lines 7 Pit privy 10 Livestock pens 14 Abandoned water well
 2 Sewer lines 5 Cess pool 8 Sewage lagoon 11 Fuel storage 15 Oil well/Gas well
 3 Watertight sewer lines 6 Seepage pit 9 Feedyard 12 Fertilizer storage 16 Other (specify below)
 13 Insecticide storage
 Direction from well? North How many feet? 100'

FROM	TO	LITHOLOGIC LOG	FROM	TO	PLUGGING INTERVALS
0	4	Top Soil BIK			
4	9	Clay Brn			
9	15	LIME-Yel-Frac.			
15	22	Shale-Blue-Green-Yel			
22	24	Shale Yel			
24	51	LIME TAN			
51	58	Shale Gray			
58	68	LIME & Flint Gray			
68	70	Break (WATER)			
70	75	LIME & Flint			

7 CONTRACTOR'S OR LANDOWNER'S CERTIFICATION: This water well was (1) constructed, (2) reconstructed, or (3) plugged under my jurisdiction and was completed on (mo/day/year) Sep 21 06 and this record is true to the best of my knowledge and belief. Kansas Water Well Contractor's Licence No 218 This Water Well Record was completed on (mo/day/yr) Oct 15 06 under the business name of ZINN Water Well Drlg. by (signature) Joseph A. Zinn