USE TYPEWRITER OR BALL POINT PEN-PRESS FIRMLY, PRINT CLEARLY.

T	R	EW	sec	1/4	1/4	1/4	No.			

WATER WELL RECORD
KSA 82a-1201-1215

Kansas State Dept. Of Health
(Water Well Contractors)
Forbes-Bldg. 740
Topeka, Kansas 66620

1 Location of well:	County	Township name	Fraction	Section number	Town number	Range number
	Morris	HighLand	SW¼SE¼SE¼	20	15	6 E

Distance and direction from nearest town or city: 4Mi. North 1-1/2 Mi. East Of Delavan Ks.

Street address of well location if in city:

3 Owner of well: Walter Paige
R.R. 1 White City, Kansas
Address:

Locate with "X" in section below:

Sketch map:

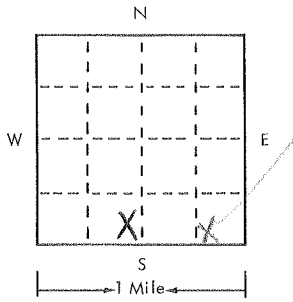

CDD DDC

4 Well depth: 110 ft. Date of completion 4-24-75
Well diameter 9 in.

5 [X] Cable tool [ ] Rotary [ ] Driven [ ] Dug
[ ] Hollow rod [ ] Jetted [ ] Bored [ ] Reverse rotary

6 Use: [X] Domestic [ ] Public supply [ ] Industry
[ ] Irrigation [ ] Air conditioning [ ] Commercial
[ ] Test well [ ]

7 Casing: Material Plastic Height: above/below
Threaded [ ] Welded [ ] Surface 12 in.
Diam. Class Weight 160 lbs./ft.
5 in. to 110 ft. depth Drive shoe? [ ] Yes [X] No
___ in. to ___ ft. depth

8 Screen:
Manufacturer Certain-teed
Type Plastic Dia. 5In.
Slot/gauze 1/8 Length 15
Set between 80 ft. and 95 ft.
Fittings:
Gravel pack [X] Yes [ ] No Size range of material 1/4

9 Static water level:
70 ft. below land surface Date 4-24

10 Pumping level below land surfaces:
___ ft. after ___ hrs. pumping ___ g.p.m.
___ ft. after ___ hrs. pumping ___ g.p.m.
Estimated maximum yield ___ g.p.m.

11 Water sample submitted:
[ ] Yes [X] No Date ___

12 Well head completion:
[ ] Pitless adapter [ ] Inches above grade

13 Well grouted? [X] Yes [ ] No
[X] Neat cement [ ] Bentonite [ ]
Depth: From 0 ft. to 10 ft.

14 Nearest source of possible contamination:
ft. 100 Direction North Type Barnyard
Well disinfected upon completion? [X] Yes [ ] No

15 Pump: [X] Not installed
Manufacturer's name
Model number HP Volts
Length of drop pipe ft. capacity g.m.p.
Type:
[ ] Submersible [ ] Turbine
[ ] Jet [ ] Reciprocating
[ ] Certrifugal [ ] Other

2 Type and color of material	From	To
Clay	0	15
Limestone	15	35
Clay	35	52
Blue Shale	52	55
Red Shale	55	85
Lime stone	85	92
Water	92	95
Limestone	95	110
(use a second sheet if needed)		

16 Remarks: elevation

Topography:
[ ] Hill
[ ] Slope
[ ] Upland
[X] Valley

17 Water well contractor's certification:
This well was drilled under my jurisdiction and this report is true to the best of my knowledge and belief.
Backhus Drilling 180
Business name License No.
Address Tampa, Kansas
Signed [signature] Date 5-7-75
Authorized representative

Forward the white, blue and pink copies to the Kansas State Dept. Of Health.

Form WWC-5