USE TYPEWRITER OR BALL POINT PEN-PRESS FIRMLY, PRINT CLEARLY.

WATER WELL RECORD
KSA 82a-1201-1215

Kansas Department of Health and Environment-Division of Environment
(Water well Contractors)
Topeka, Kansas 66620

1. Location of well:	County	Fraction	Section number	Township number	Range number
	Morris	SW 1/4 SW 1/4 NW 1/4	29	T 15 S	R 6 E/W

2. Distance and direction from nearest town or city: 5 S 3 W
Street address of well location if in city: White City

3. Owner of well: Billy Paige
R.R. or street: RR 1
City, state, zip code: White City, Ks 66872

4. Locate with "X" in section below:

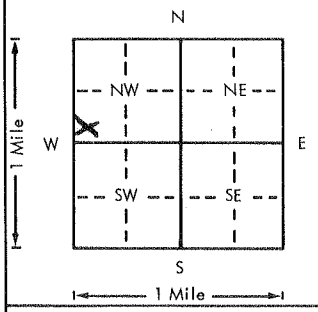

Sketch map:

BCC

6. Bore hole dia. 9 in. Completion date 3-17-76
Well depth 106 ft.

7. X Cable tool __ Rotary __ Driven __ Dug
__ Hollow rod __ Jetted __ Bored __ Reverse rotary

8. Use: X Domestic __ Public supply __ Industry
__ Irrigation __ Air conditioning __ Stock
__ Lawn __ Oil field water __ Other

9. Casing: Material PVC Height: Above or below
Threaded __ Welded __ Surface 12 in.
RMP __ PVC X Weight 160 lbs./ft.
Dia. 5 in. to 106 ft. depth Wall Thickness: inches or
Dia. __ in. to __ ft. depth gage No. 1023

5. Type and color of material	From	To
Top Soil	0	3
yellow Shale	3	16
lime Stone	16	34
yellow Clay + Shale	34	67
Red Shale	67	80
lime Stone	80	84
Some Water	84	
lime Stone	84	98
Water	98	
lime Stone	98	106

(Use a second sheet if needed)

10. Screen: Manufacturer's name Pumpco
Type PVC Dia. 5"
Slot/gauze 50 Length 20'
Set between 84 ft. and 104 ft.
ft. and ft.
Gravel pack? X Size range of material 40 to 80

11. Static water level: mo./day/yr.
72 ft. below land surface Date 3-17-76

12. Pumping level below land surfaces:
ft. after hrs. pumping g.p.m.
ft. after hrs. pumping g.p.m.
Estimated maximum yield g.p.m.

13. Water sample submitted: mo./day/yr.
__ Yes X No Date

14. Well head completion: well House
__ Pitless adapter __ Inches above grade

15. Well grouted? X
With: __ Neat cement __ Bentonite X Concrete
Depth: From 0 ft. to 10 ft.

16. Nearest source of possible contamination: Sewer line
ft. 60 Direction NE Type
Well disinfected upon completion? X Yes __ No

17. Pump: X Not installed
Manufacturer's name
Model number HP Volts
Length of drop pipe ft. capacity g.p.m.
Type:
__ Submersible __ Turbine
__ Jet __ Reciprocating
__ Centrifugal __ Other

18. Elevation:
Topography:
__ Hill
__ Slope
X Upland
__ Valley

19. Remarks:
Pump not installed by
My company

20. Water well contractor's certification:
This well was drilled under my jurisdiction and this report is true to the best of my knowledge and belief.
Business name Backhus Drg. License No. 180
Address Tampa Ks. 67483
Signed Ralph H. Backhus Date
Authorized representative 3-17-76

T 15 R 6 E/W Sec 29 1/4 SW 1/4 SW 1/4 NW 1/4

Forward the white, blue and pink copies to the Department of Health and Environment

Form WWC-5

M1-1023