


1 LOCATION OF WATER WELL: Fraction N/W 1/4 NW 1/4 SW 1/4 Section Number 24 Township Number T 15 S Range Number R 6 EW  
 County: Morris  
 Distance and direction from nearest town or city street address of well if located within city?  
6 mile East & 1/2 mile North of Council Grove

2 WATER WELL OWNER: Debby Dudley  
 RR#, St. Address, Box #: RTI Box 111 Board of Agriculture, Division of Water Resources  
 City, State, ZIP Code: Council Grove, Ks 66846 Application Number:

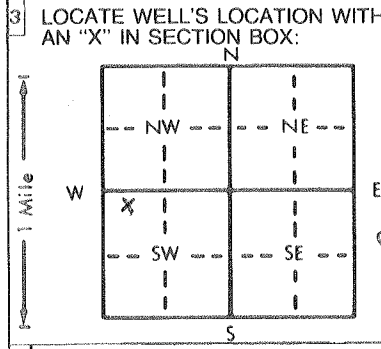

4 DEPTH OF COMPLETED WELL: 50 ft. ELEVATION:  
 Depth(s) Groundwater Encountered 1. 26 ft. 2. ft. 3. ft.  
 WELL'S STATIC WATER LEVEL: 20 ft. below land surface measured on mo/day/yr Apr. 10 98  
 Pump test data: Well water was ft. after hours pumping gpm  
 Est. Yield 2 gpm. Well water was ft. after hours pumping gpm  
 Bore Hole Diameter: 8 7/8 in. to 2 1/2 ft., and 7 in. to 50 ft.  
 WELL WATER TO BE USED AS:  
 1 Domestic  3 Feedlot  6 Oil field water supply  9 Dewatering  12 Other (Specify below)  
 2 Irrigation  4 Industrial  7 Lawn and garden only  10 Monitoring well  
 Was a chemical/bacteriological sample submitted to Department? Yes  No ; If yes, mo/day/yr sample was submitted  
 Water Well Disinfected?  Yes  No

5 TYPE OF BLANK CASING USED:  
 1 Steel  3 RMP (SR)  6 Asbestos-Cement  9 Other (specify below)  Welded  
 PVC  4 ABS  7 Fiberglass  Threaded  
 Blank casing diameter: 5 in. to 2 1/2 ft., Dia. in. to ft., Dia. in. to ft.  
 Casing height above land surface: 18 in., weight lbs./ft. Wall thickness or gauge No. SDR-26  
 TYPE OF SCREEN OR PERFORATION MATERIAL:  
 1 Steel  3 Stainless steel  5 Fiberglass  7 PVC  10 Asbestos-cement  
 2 Brass  4 Galvanized steel  6 Concrete tile  8 RMP (SR)  11 Other (specify)  
 SCREEN OR PERFORATION OPENINGS ARE:  
 1 Continuous slot  5 Gauzed wrapped  8 Saw cut  11 None (open hole)  
 2 Louvered shutter  3 Mill slot  6 Wire wrapped  9 Drilled holes  
 4 Key punched  7 Torch cut  10 Other (specify)  
 SCREEN-PERFORATED INTERVALS: From 26 ft. to 50 ft., From ft. to ft., From ft. to ft.  
 GRAVEL PACK INTERVALS: From NONE ft. to ft., From ft. to ft., From ft. to ft.

6 GROUT MATERIAL:  1 Neat cement  2 Cement grout  3 Bentonite  4 Other  
 Grout Intervals: From 3 ft. to 24 ft., From ft. to ft., From ft. to ft., From ft. to ft.  
 What is the nearest source of possible contamination:  
 1 Septic tank  4 Lateral lines  7 Pit privy  10 Livestock pens  14 Abandoned water well  
 2 Sewer lines  5 Cess pool  8 Sewage lagoon  11 Fuel storage  15 Oil well/Gas well  
 3 Watertight sewer lines  6 Seepage pit  9 Feedyard  12 Fertilizer storage  16 Other (specify below)  
 13 Insecticide storage  
 Direction from well? South East How many feet? 300

FROM	TO	LITHOLOGIC LOG	FROM	TO	PLUGGING INTERVALS
0	2	Top Soil			
2	6	Clay TAN			
6	8	SOME Gravel			
8	14	LIME Yel.			
14	22	Shale Gray			
22	23	LIME Gray			
23	26	Shale Gray			
26	31	LIME Gray			
31	36	Shale Blue Green			
36	38	LIME Lite Gray			
38	41	Shale Green			
41	44	LIME Lite Gray			
44	50	Shale Lite Gray			

7 CONTRACTOR'S OR LANDOWNER'S CERTIFICATION: This water well was  (1) constructed,  (2) reconstructed, or  (3) plugged under my jurisdiction and was completed on (mo/day/year) Apr. 10-98 and this record is true to the best of my knowledge and belief. Kansas Water Well Contractor's License No. 218 This Water Well Record was completed on (mo/day/yr) May 7 98 under the business name of Zinn Water Well Dnlg by (signature) Joseph A. Zinn