

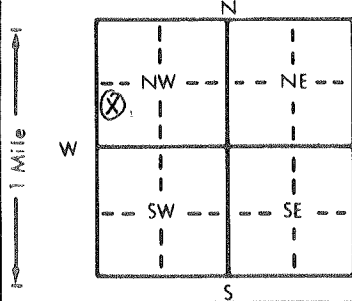
1 LOCATION OF WATER WELL:	Fraction	Section Number	Township Number	Range Number
County: <u>Morris</u>	<u>NW 1/4 SW 1/4 NW 1/4</u>	<u>31</u>	T <u>15</u> S	R <u>6</u> <u>W</u>

Distance and direction from nearest town or city street address of well if located within city?

3 Miles North of Delavan, KS

2 WATER WELL OWNER: <u>U. S. Corps of Engineers</u>	Board of Agriculture, Division of Water Resources
RR#, St. Address, Box #: <u>700 Federal Building</u>	Application Number:
City, State, ZIP Code: <u>601 E. 12th St. Kansas City, MO 64106-2895</u>	

3 LOCATE WELL'S LOCATION WITH AN "X" IN SECTION BOX:	4 DEPTH OF COMPLETED WELL: <u>55</u> ft. ELEVATION:
--	---

Depth(s) Groundwater Encountered 1. 31.5 ft. 2. ft. 3. ft.WELL'S STATIC WATER LEVEL 31.5 ft. below land surface measured on mo/day/yr 1/25/95

Pump test data: Well water was ft. after hours pumping gpm

Est. Yield <1 gpm: Well water was ft. after hours pumping gpmBore Hole Diameter 6 in. to 55 ft. and in. to ft.

WELL WATER TO BE USED AS: 5 Public water supply 8 Air conditioning 11 Injection well

1 Domestic 3 Feedlot 6 Oil field water supply 9 Dewatering 12 Other (Specify below)

2 Irrigation 4 Industrial 7 Lawn and garden only 10 Monitoring well PressureWas a chemical/bacteriological sample submitted to Department? Yes No X; If yes, mo/day/yr sample was submittedWater Well Disinfected? Yes N/A No

5 TYPE OF BLANK CASING USED:	5 Wrought iron	8 Concrete tile	CASING JOINTS: Glued Clamped
------------------------------	----------------	-----------------	------------------------------

1 Steel 3 RMP (SR) 6 Asbestos-Cement 9 Other (specify below) Welded

2 PVC 4 ABS 7 Fiberglass Threaded XBlank casing diameter 2 in. to 45 ft. Dia in. to ft. Dia in. to ft.Casing height above land surface 30 in. weight lbs/ft. Wall thickness or gauge No. Sched 40

TYPE OF SCREEN OR PERFORATION MATERIAL: 7 PVC 10 Asbestos-cement

1 Steel 3 Stainless steel 5 Fiberglass 8 RMP (SR) 11 Other (specify)

2 Brass 4 Galvanized steel 6 Concrete tile 9 ABS 12 None used (open hole)

SCREEN OR PERFORATION OPENINGS ARE: 5 Gauzed wrapped 8 Saw cut 11 None (open hole)

1 Continuous slot 3 Mill slot .010" 6 Wire wrapped 9 Drilled holes

2 Louvered shutter 4 Key punched 7 Torch cut 10 Other (specify)

SCREEN-PERFORATED INTERVALS: From 45 ft. to 55 ft. From ft. to ft.

From ft. to ft. From ft. to ft.

GRAVEL PACK INTERVALS: From 55 ft. to 41 ft. From ft. to ft.

From ft. to ft. From ft. to ft.

6 GROUT MATERIAL:	1 Neat cement	2 Cement grout	3 Bentonite	4 Other <u>Concrete</u>
-------------------	---------------	----------------	-------------	-------------------------

Grout Intervals: From 41 ft. to 36 ft. From 36 ft. to 3 ft. From 3 ft. to 0 ft.

What is the nearest source of possible contamination: 10 Livestock pens 14 Abandoned water well

1 Septic tank 4 Lateral lines 7 Pit privy 11 Fuel storage 15 Oil well/Gas well

2 Sewer lines 5 Cess pool 8 Sewage lagoon 12 Fertilizer storage 16 Other (specify below)

3 Watertight sewer lines 6 Seepage pit 9 Feedyard 13 Insecticide storage Former DOD AirfieldDirection from well? SE How many feet? 1200

FROM	TO	LITHOLOGIC LOG	FROM	TO	PLUGGING INTERVALS
<u>0</u>	<u>7</u>	<u>Black brown clay</u>			
<u>7</u>	<u>44</u>	<u>Limestone, orange to gray</u>			
<u>44</u>	<u>49</u>	<u>Claystone</u>			
<u>49</u>	<u>55</u>	<u>Limestone, orange to olive</u>			

7 CONTRACTOR'S OR LANDOWNER'S CERTIFICATION: This water well was (1) constructed, (2) reconstructed, or (3) plugged under my jurisdiction and was completed on (mo/day/year) <u>1/25/95</u> and this record is true to the best of my knowledge and belief. Kansas Water Well Contractor's License No. <u>555</u> This Water Well Record was completed on (mo/day/yr) <u>2/21/95</u> under the business name of <u>A.W. Pool, Inc.</u> by (signature) <u>Keith Pool</u>
