

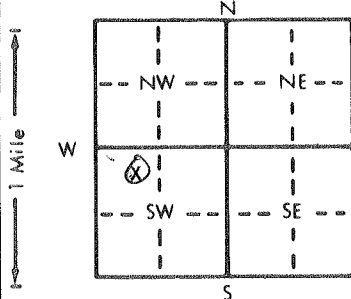
1 LOCATION OF WATER WELL:	Fraction	Section Number	Township Number	Range Number
County: <u>Morris</u> <u>064</u>	<u>NE 1/4 NW 1/4 SW 1/4</u>	<u>31</u>	T <u>15</u> S	R <u>6</u> EW

Distance and direction from nearest town or city street address of well if located within city?

3 Miles North of Delavan, KS

2 WATER WELL OWNER: <u>U. S. Corps of Engineers</u>	Board of Agriculture, Division of Water Resource
RR#, St. Address, Box #: <u>700 Federal Building</u>	Application Number:
City, State, ZIP Code: <u>601 E. 12th St. Kansas City, MO 64106-2895</u>	

3 LOCATE WELL'S LOCATION WITH AN "X" IN SECTION BOX:	4 DEPTH OF COMPLETED WELL: <u>80</u> ft. ELEVATION:
--	---

Depth(s) Groundwater Encountered 1. 76 ft. 2. ft. 3. ft.WELL'S STATIC WATER LEVEL 72 ft. below land surface measured on mo/day/yr 1/25/95

Pump test data: Well water was ft. after hours pumping gpm

Est. Yield <1 gpm: Well water was ft. after hours pumping gpmBore Hole Diameter 6 in. to 80 ft., and in. to ft.

WELL WATER TO BE USED AS: 5 Public water supply 8 Air conditioning 11 Injection well

1 Domestic 3 Feedlot 6 Oil field water supply 9 Dewatering 12 Other (Specify below)

2 Irrigation 4 Industrial 7 Lawn and garden only 10 Monitoring well

Was a chemical/bacteriological sample submitted to Department? Yes X No; If yes, mo/day/yr sample was submittedSubmitted by ENGINEER - BURNS, MCDONALD Water Well Disinfected? Yes N/A No

5 TYPE OF BLANK CASING USED:	5 Wrought iron	8 Concrete tile	CASING JOINTS: Glued Clamped
------------------------------	----------------	-----------------	------------------------------

1 Steel 3 RMP (SR) 6 Asbestos-Cement 9 Other (specify below) Welded

(2) PVC 4 ABS 7 Fiberglass Threaded XBlank casing diameter 2 in. to 70 ft., Dia. in. to ft., Dia. in. to ft.Casing height above land surface 30 in., weight lbs./ft. Wall thickness or gauge No. Sched. 40

TYPE OF SCREEN OR PERFORATION MATERIAL:

1 Steel 3 Stainless steel 5 Fiberglass 8 RMP (SR) 10 Asbestos-cement

2 Brass 4 Galvanized steel 6 Concrete tile 9 ABS 11 Other (specify)

SCREEN OR PERFORATION OPENINGS ARE: 5 Gauzed wrapped 8 Saw cut 11 None (open hole)

1 Continuous slot 3 Mill slot .010" 6 Wire wrapped 9 Drilled holes

2 Louvered shutter 4 Key punched 7 Torch cut 10 Other (specify)

SCREEN-PERFORATED INTERVALS: From 70 ft. to 80 ft., From ft. to ft.

From ft. to ft., From ft. to ft.

GRAVEL PACK INTERVALS: From 67 ft. to 80 ft., From ft. to ft.

From ft. to ft., From ft. to ft.

6 GROUT MATERIAL:	1 Neat cement	2 Cement grout	3 Bentonite	4 Other <u>Concrete</u>
-------------------	---------------	----------------	-------------	-------------------------

Grout Intervals: From 67 ft. to 62 ft., From 62 ft. to 3 ft., From 3 ft. to 0 ft.

What is the nearest source of possible contamination:

1 Septic tank 4 Lateral lines 7 Pit privy 10 Livestock pens 14 Abandoned water well

2 Sewer lines 5 Cess pool 8 Sewage lagoon 11 Fuel storage 15 Oil well/Gas well

3 Watertight sewer lines 6 Seepage pit 9 Feedyard 12 Fertilizer storage 16 Other (specify below)

DOD Airfield (former)Direction from well? On site @ MAINTENANCE HANGER AREA How many feet? Brown AAF

FROM	TO	LITHOLOGIC LOG	FROM	TO	PLUGGING INTERVALS
<u>0</u>	<u>6</u>	<u>Brown &amp; Black Clay</u>			
<u>6</u>	<u>10</u>	<u>Limestone</u>			
<u>10</u>	<u>16</u>	<u>Brown shale</u>			
<u>16</u>	<u>39</u>	<u>Claystone</u>			
<u>39</u>	<u>44</u>	<u>Grey Limestone</u>			
<u>44</u>	<u>47</u>	<u>Claystone</u>			
<u>47</u>	<u>59</u>	<u>Yellow gray dolostone</u>			
<u>59</u>	<u>80</u>	<u>Limestone</u>			

7 CONTRACTOR'S OR LANDOWNER'S CERTIFICATION: This water well was (1) constructed, (2) reconstructed, or (3) plugged under my jurisdiction and was completed on (mo/day/year) <u>1/25/95</u> and this record is true to the best of my knowledge and belief. Kansas
--

Water Well Contractor's License No. 555 This Water Well Record was completed on (mo/day/yr) 2/3/95under the business name of A.W. Pool, Inc. by (signature) [Signature]