


1 LOCATION OF WATER WELL:	Fraction	Section Number	Township Number	Range Number
County: Morris 064 NW 1/4 NW 1/4 SW 1/4	31	T 15 S	R 6 E	EW

Distance and direction from nearest town or city street address of well if located within city?

3 Miles North of Delavan, KS

2 WATER WELL OWNER:	U. S. Corps of Engineers	Board of Agriculture, Division of Water Resources
RR#, St. Address, Box #:	700 Federal Building	Application Number:
City, State, ZIP Code:	601 E. 12th St. Kansas City, MO 64106-2895	

3 LOCATE WELL'S LOCATION WITH AN "X" IN SECTION BOX:	4 DEPTH OF COMPLETED WELL:	ft. ELEVATION:
--	----------------------------	----------------

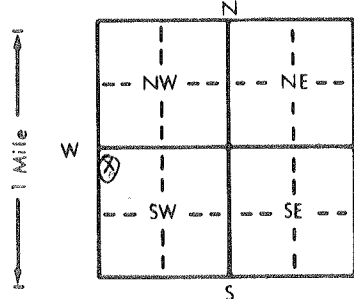

Depth(s) Groundwater Encountered 1. 47 ft. 2. ft. 3. ft.

WELL'S STATIC WATER LEVEL 47 ft. below land surface measured on mo/day/yr 1/25/95

Pump test data: Well water was ft. after hours pumping gpm

Est. Yield <1 gpm: Well water was ft. after hours pumping gpm

Bore Hole Diameter 6 in. to 70 ft., and in. to ft.

WELL WATER TO BE USED AS: 5 Public water supply 8 Air conditioning 11 Injection well

1 Domestic 3 Feedlot 6 Oil field water supply 9 Dewatering 12 Other (Specify below)

2 Irrigation 4 Industrial 7 Lawn and garden only 10 Monitoring well

Was a chemical/bacteriological sample submitted to Department? Yes X No; If yes, mo/day/yr sample was submitted Submitted by Engineer - Burns; McDermott

Water Well Disinfected? Yes N/A No

5 TYPE OF BLANK CASING USED:	5 Wrought iron	8 Concrete tile	CASING JOINTS: Glued Clamped
------------------------------	----------------	-----------------	------------------------------

1 Steel 3 RMP (SR) 6 Asbestos-Cement 9 Other (specify below) Welded

2 PVC 4 ABS 7 Fiberglass Threaded X

Blank casing diameter 2 in. to 60 ft., Dia in. to ft., Dia in. to ft.

Casing height above land surface 30 in., weight lbs./ft. Wall thickness or gauge No. Sched 40

TYPE OF SCREEN OR PERFORATION MATERIAL:

1 Steel 3 Stainless steel 5 Fiberglass 8 RMP (SR) 10 Asbestos-cement

2 Brass 4 Galvanized steel 6 Concrete tile 9 ABS 11 Other (specify)

SCREEN OR PERFORATION OPENINGS ARE:

1 Continuous slot 3 Mill slot .010" 5 Gauzed wrapped 8 Saw cut 11 None (open hole)

2 Louvered shutter 4 Key punched 6 Wire wrapped 9 Drilled holes

SCREEN-PERFORATED INTERVALS: From 60 ft. to 70 ft., From ft. to ft.

GRAVEL PACK INTERVALS: From 57 ft. to 70 ft., From ft. to ft.

From ft. to ft., From ft. to ft.

From ft. to ft., From ft. to ft.

6 GROUT MATERIAL: 1 Neat cement 2 Cement grout 3 Bentonite 4 Other Concrete

Grout Intervals: From 57 ft. to 52 ft., From 52 ft. to 3 ft., From 3 ft. to 0 ft.

What is the nearest source of possible contamination:

1 Septic tank 4 Lateral lines 7 Pit privy 10 Livestock pens 14 Abandoned water well

2 Sewer lines 5 Cess pool 8 Sewage lagoon 11 Fuel storage 15 Oil well/Gas well

3 Watertight sewer lines 6 Seepage pit 9 Feedyard 12 Fertilizer storage 16 Other (specify below)

Direction from well? EAST of Well # 21402 How many feet? 1000 Former DOD Airfield Former Maintenance Pool

FROM	TO	LITHOLOGIC LOG	FROM	TO	PLUGGING INTERVALS
0	4	Black moist clay			
4	10	Moist to damp brown clay			
10	17	Reddish brown clay			
17	21	Claystone			
21	25	Yellowish grey limestone			
25	28	Light brown clay stone			
28	32	Yellow grey limestone			
32	38	Pale orange limestone			
38	44	Dusky yellow limestone			
44	46	Moderate yellow limestone			
46	55	shale			
55	60	Very Pale Orange limestone			
60	65	claystone			
65	70	Dusky yellow limestone			

7 CONTRACTOR'S OR LANDOWNER'S CERTIFICATION: This water well was (1) constructed, (2) reconstructed, or (3) plugged under my jurisdiction and was completed on (mo/day/year) 1/25/95 and this record is true to the best of my knowledge and belief. Kansas
---

Water Well Contractor's License No. 555 This Water Well Record was completed on (mo/day/yr) 12/21/95

under the business name of A.W. Pool, Inc. by (signature) Keith Pool