


1 LOCATION OF WATER WELL:	Fraction	Section Number	Township Number	Range Number
County: Morris	004 NW 1/4 NW 1/4 NW 1/4	31	T 15 S	R 6 EW

Distance and direction from nearest town or city street address of well if located within city?

3 Miles North of Delavan, KS.

2 WATER WELL OWNER:	U. S. Corps of Engineers	64106-2895	Board of Agriculture, Division of Water Resources
RR#, St. Address, Box # :	700 Federal Building		Application Number:
City, State, ZIP Code :	601 East 12th Street Kansas City, MO		

3 LOCATE WELL'S LOCATION WITH AN "X" IN SECTION BOX:	4 DEPTH OF COMPLETED WELL: 70.3 ft. ELEVATION:
--	--

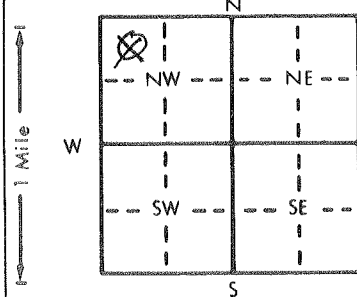

Depth(s) Groundwater Encountered 1. 65 ft. 2. ft. 3. ft.

WELL'S STATIC WATER LEVEL 60 ft. below land surface measured on mo/day/yr 1/25/95

Pump test data: Well water was ft. after hours pumping gpm

Est. Yield &lt;1 gpm: Well water was ft. after hours pumping gpm

Bore Hole Diameter 1.0 in. to 25 ft., and 6 in. to 70.3 ft.

WELL WATER TO BE USED AS: 5 Public water supply 8 Air conditioning 11 Injection well

1 Domestic 3 Feedlot 6 Oil field water supply 9 Dewatering 12 Other (Specify below)

2 Irrigation 4 Industrial 7 Lawn and garden only 10 Monitoring well Piezometer

Was a chemical/bacteriological sample submitted to Department? Yes No X If yes, mo/day/yr sample was submitted

Water Well Disinfected? Yes N/A No

5 TYPE OF BLANK CASING USED:	5 Wrought iron	8 Concrete tile	CASING JOINTS: Glued Clamped
------------------------------	----------------	-----------------	------------------------------

1 Steel 3 RMP (SR) 6 Asbestos-Cement 9 Other (specify below) Welded

2 PVC 4 ABS 7 Fiberglass 8 RMP (SR) Threaded X

Blank casing diameter 2 2 in. to 60.3 ft. Dia 2 6 in. to 25 ft. Dia in. to ft.

Casing height above land surface 30 in. weight lbs./ft. Wall thickness or gauge No. Sched 40

TYPE OF SCREEN OR PERFORATION MATERIAL:	10 Asbestos-cement
---	--------------------

1 Steel 3 Stainless steel 5 Fiberglass 8 RMP (SR) 11 Other (specify)

2 Brass 4 Galvanized steel 6 Concrete tile 9 ABS 12 None used (open hole)

SCREEN OR PERFORATION OPENINGS ARE:	5 Gauzed wrapped	8 Saw cut	11 None (open hole)
-------------------------------------	------------------	-----------	---------------------

1 Continuous slot 3 Mill slot .010" 6 Wire wrapped 9 Drilled holes

2 Louvered shutter 4 Key punched 7 Torch cut 10 Other (specify)

SCREEN-PERFORATED INTERVALS:	From 60.3 ft. to 70.3 ft.	From ft. to ft.
------------------------------	---------------------------	-----------------

From ft. to ft. From ft. to ft.

GRAVEL PACK INTERVALS: From 5.7 ft. to 70.3 ft. From ft. to ft.

From ft. to ft. From ft. to ft.

6 GROUT MATERIAL:	1 Neat cement	2 Cement grout	3 Bentonite	4 Other Concrete
-------------------	---------------	----------------	-------------	------------------

Grout Intervals: From 5.7 ft. to 5.7 ft. From 5.7 ft. to 3 ft. From 3 ft. to 0 ft.

What is the nearest source of possible contamination: From 25 ft. to 3 ft. Surface Seal

1 Septic tank 4 Lateral lines 7 Pit privy 10 Livestock pens 14 Abandoned water well

2 Sewer lines 5 Cess pool 8 Sewage lagoon 11 Fuel storage 15 Oil well/Gas well

3 Watertight sewer lines 6 Seepage pit 9 Feedyard 12 Fertilizer storage 16 Other (specify below)

How many feet? 2000

Direction from well? S	FROM	TO	LITHOLOGIC LOG	FROM	TO	PLUGGING INTERVALS
------------------------	------	----	----------------	------	----	--------------------

0 4 Dark brown clay

4 10 Limestone

10 19 Claystone

19 32 Limestone, yellowish gray

32 34 Claystone

34 70.3 Limestone

7 CONTRACTOR'S OR LANDOWNER'S CERTIFICATION:	This water well was (1) constructed, (2) reconstructed, or (3) plugged under my jurisdiction and was completed on (mo/day/year) 1/25/95 and this record is true to the best of my knowledge and belief. Kansas
--	--

Water Well Contractor's License No. 555 This Water Well Record was completed on (mo/day/yr) 2/20/95

under the business name of A. W. Pool, Inc. by (signature) Keith Pool

INSTRUCTIONS: Use typewriter or ball point pen. PLEASE PRESS FIRMLY and PRINT clearly. Please fill in blanks, underline or circle the correct answers. Send top three copies to Kansas Department of Health and Environment, Bureau of Water, Topeka, Kansas 66620-0001. Telephone: 913-296-5545. Send one to WATER WELL OWNER and retain one for your records.