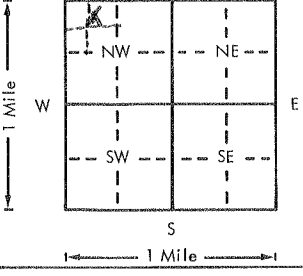
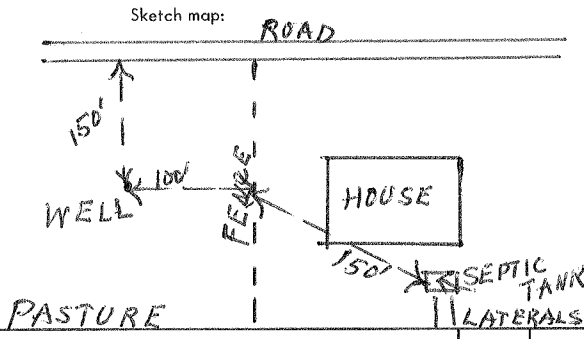


USE TYPEWRITER OR BALL
POINT PEN-PRESS FIRMLY,
PRINT CLEARLY.

WATER WELL RECORD
KSA 82a-1201-1215

Kansas Department of Health and
Environment-Division of Environment
(Water well Contractors)
Topeka, Kansas 66620

1. Location of well:		County Morris	Fraction NE 1/4 NW 1/4 NW 1/4	Section number 5	Township number T 15 S R 7	Range number EW
2. Distance and direction from nearest town or city: 3 1/2 miles south-east of White City			3. Owner of well: J.D. Picolet R.R. or street: Wilsey, Kans. 66873 City, state, zip code:			
4. Locate with "X" in section below:			Sketch map:		6. Bore hole dia. 8 in. Completion date 1/27/77 Well depth 74 ft.	
					7. <input type="checkbox"/> Cable tool <input checked="" type="checkbox"/> Rotary <input type="checkbox"/> Driven <input type="checkbox"/> Dug <input type="checkbox"/> Hollow rod <input type="checkbox"/> Jetted <input type="checkbox"/> Bored <input type="checkbox"/> Reverse rotary	
5. Type and color of material			From	To	8. Use: <input checked="" type="checkbox"/> Domestic <input type="checkbox"/> Public supply <input type="checkbox"/> Industry <input type="checkbox"/> Irrigation <input type="checkbox"/> Air conditioning <input type="checkbox"/> Stock <input type="checkbox"/> Lawn <input type="checkbox"/> Oil field water <input type="checkbox"/> Other	
Top soil			0	4	9. Casing: Material plst Height: Above or below Threaded <input type="checkbox"/> Welded <input checked="" type="checkbox"/> Surface 18 in. RMP <input checked="" type="checkbox"/> PVC <input type="checkbox"/> Weight <input type="checkbox"/> lbs./ft. Dia. 5 in. to 7 1/4 ft. depth Wall Thickness: inches or Dia. <input type="checkbox"/> in. to <input type="checkbox"/> ft. depth gage No. 0.258	
Hard limestone and flint			4	26	10. Screen: Manufacturer's name Western Plastics Type RMP Dia. 5 1/2 Slot/gauze 2/32 Length 50 Set between 24 ft. and 74 ft. ft. and <input type="checkbox"/> ft. Gravel pack? Yes Size range of material 1/16 to 3/8	
Gray shale			40	48	11. Static water level: 24 ft. below land surface Date 1/27/77 mo./day/yr.	
Red shale			48	52	12. Pumping level below land surfaces: ft. after <input type="checkbox"/> hrs. pumping <input type="checkbox"/> g.p.m. ft. after <input type="checkbox"/> hrs. pumping <input type="checkbox"/> g.p.m. Estimated maximum yield 5 g.p.m.	
Gray shale			52	58	13. Water sample submitted: <input type="checkbox"/> Yes <input checked="" type="checkbox"/> No Date <input type="checkbox"/>	
White shale			58	61	14. Well head completion: <input type="checkbox"/> Pitless adapter 18 inches above grade	
Blue green shale			61	63	15. Well grouted? Yes With: <input checked="" type="checkbox"/> Neat cement <input type="checkbox"/> Bentonite <input type="checkbox"/> Concrete Depth: From 0 ft. to 10 ft.	
Red shale			63	65	16. Nearest source of possible contamination: septic tank ft. 250 Direction S.E. Type tank Well disinfected upon completion? <input checked="" type="checkbox"/> Yes <input type="checkbox"/> No	
(Use a second sheet if needed)					17. Pump: <input checked="" type="checkbox"/> Not installed Manufacturer's name <input type="checkbox"/> Model number <input type="checkbox"/> HP <input type="checkbox"/> Volts <input type="checkbox"/> Length of drop pipe <input type="checkbox"/> ft. capacity <input type="checkbox"/> g.p.m. Type: <input type="checkbox"/> Submersible <input type="checkbox"/> Turbine <input type="checkbox"/> Jet <input type="checkbox"/> Reciprocating <input type="checkbox"/> Centrifugal <input type="checkbox"/> Other	
18. Elevation:		19. Remarks:		20. Water well contractor's certification: This well was drilled under my jurisdiction and this report is true to the best of my knowledge and belief. Rader Drilling Co. 194 Business name License No. Address Carlton, Kans. 67429 Signed Donald P. Rader Date 2-4-77 Authorized representative		