

1 LOCATION OF WATER WELL: County: <u>Morris</u>	Fraction <u>NE 1/4 NE 1/4 SE 1/4</u>	Section Number <u>8</u>	Township Number T <u>15</u> S	Range Number R <u>7</u> EW
--	---	----------------------------	----------------------------------	-------------------------------

Distance and direction from nearest town or city street address of well if located within city?

1/4 mile SW of Parkerville2 WATER WELL OWNER: Bill Panker

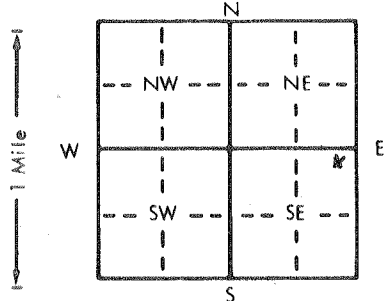
RR#, St. Address, Box # :

City, State, ZIP Code : Parkerville, Ks

Board of Agriculture, Division of Water Resources

Application Number:

3 LOCATE WELL'S LOCATION WITH AN "X" IN SECTION BOX:


WELL WATER TO BE USED AS: 5 Public water supply 8 Air conditioning 11 Injection well

1 Domestic 3 Feedlot 6 Oil field water supply 9 Dewatering 12 Other (Specify below)

2 Irrigation 4 Industrial 7 Lawn and garden only 10 Observation well

Was a chemical/bacteriological sample submitted to Department? Yes No; If yes, mo/day/yr sample was submittedWater Well Disinfected? Yes No

5 TYPE OF BLANK CASING USED:

5 Wrought iron 8 Concrete tile CASING JOINTS Glued Clamped

6 Asbestos-Cement 9 Other (specify below) Welded

7 Fiberglass Threaded


TYPE OF SCREEN OR PERFORATION MATERIAL:

7 PVC 10 Asbestos-cement

8 RMP (SR) 11 Other (specify)

9 ABS 12 None used (open hole)

SCREEN OR PERFORATION OPENINGS ARE:

5 Gauzed wrapped 8 Saw cut 11 None (open hole)

6 Wire wrapped 9 Drilled holes

7 Torch cut 10 Other (specify)

SCREEN-PERFORATED INTERVALS:


GRAVEL PACK INTERVALS:


6 GROUT MATERIAL:

1 Neat cement 2 Cement grout 3 Bentonite 4 Other


What is the nearest source of possible contamination:

10 Livestock pens 14 Abandoned water well

11 Fuel storage 15 Oil well/Gas well

12 Fertilizer storage 16 Other (specify below)

13 Insecticide storage Neosho RiverHow many feet? 50 ft

Direction from well?

FROM	TO	LITHOLOGIC LOG	FROM	TO	LITHOLOGIC LOG
0	10	Black Dirt	01		
10	15	Silty Mud	03		
15	20	Gravel	11		
20	21	LIME	20		
21	26	Red Rock	19		
26	28	Shale Gray	19		
28	35	LIME - Lite	20		

7 CONTRACTOR'S OR LANDOWNER'S CERTIFICATION: This water well was 1 constructed, (2) reconstructed, or (3) plugged under my jurisdiction and wascompleted on (mo/day/year) June 30 83 and this record is true to the best of my knowledge and belief. KansasWater Well Contractor's License No. 218 This Water Well Record was completed on (mo/day/yr) Mar 26-83under the business name of Zinn Water Well Dng by (signature) Joseph A. Zinn

INSTRUCTIONS: Use typewriter or ball point pen, PLEASE PRESS FIRMLY and PRINT clearly. Please fill in blanks, underline or circle the correct answers. Send to three copies to Kansas Department of Health and Environment, Division of Environment, Environmental Geology Section, Topeka, KS 66620. Send one to WATER WELL OWNER and retain one for your records.