

1] LOCATION OF WATER WELL: County: <b>Mooris</b>	Fraction <b>SE 1/4 NW 1/4 NW 1/4</b>	Section Number <b>16</b>	Township Number T <b>15</b> S	Range Number R <b>7</b> <b>(EW)</b>
---	---	-----------------------------	----------------------------------	--

Distance and direction from nearest town or city street address of well if located within city?

**3/4 S.W. Of Parkerville**2] WATER WELL OWNER: **Steve Seth**

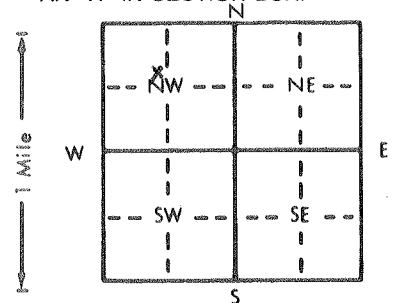
RR#, St. Address, Box # :

City, State, ZIP Code **White City, Kansas 66872**

Board of Agriculture, Division of Water Resources

Application Number:

3] LOCATE WELL'S LOCATION WITH AN "X" IN SECTION BOX:

4] DEPTH OF COMPLETED WELL: **43'** ft. ELEVATION:

Depth(s) Groundwater Encountered 1. .... ft. 2. .... ft. 3. .... ft.

WELL'S STATIC WATER LEVEL **20** ft. below land surface measured on mo/day/yr **2-24-1988**

Pump test data: Well water was .... ft. after .... hours pumping .... gpm

Est. Yield **12** gpm; Well water was .... ft. after .... hours pumping .... gpmBore Hole Diameter .... in. to **62** in. to .... ft. and .... in. to .... ft.

WELL WATER TO BE USED AS: 5 Public water supply 8 Air conditioning 11 Injection well

☒ Domestic ☒ 3 Feedlot 6 Oil field water supply 9 Dewatering 12 Other (Specify below)

2 Irrigation 4 Industrial 7 Lawn and garden only 10 Observation well

Was a chemical/bacteriological sample submitted to Department? Yes.....No.....☒ If yes, mo/day/yr sample was submitted Water Well Disinfected? Yes ☒ No

5] TYPE OF BLANK CASING USED:

1 Steel 3 RMP (SR)

2 PVC ☒ 4 ABS

5 Wrought iron

6 Asbestos-Cement

7 Fiberglass

8 Concrete tile

9 Other (specify below)

CASING JOINTS: Glued ☒ Clamped

Welded

Threaded

Blank casing diameter **5** in. to **17'** ft., Dia. .... in. to .... ft., Dia. .... in. to .... ft.Casing height above land surface **24** in., weight **200** lbs./ft. Wall thickness or gauge No. ....

TYPE OF SCREEN OR PERFORATION MATERIAL:

1 Steel 3 Stainless steel

2 Brass 4 Galvanized steel

5 Fiberglass

6 Concrete tile

7 PVC ☒

8 RMP (SR)

9 ABS

10 Asbestos-cement

11 Other (specify) ....

12 None used (open hole)

SCREEN OR PERFORATION OPENINGS ARE:

1 Continuous slot

2 Louvered shutter

3 Mill slot

4 Key punched

5 Gauzed wrapped

6 Wire wrapped

7 Torch cut

8 Saw cut ☒

9 Drilled holes

10 Other (specify) ....

11 None (open hole)

SCREEN-PERFORATED INTERVALS: From **17'** ft. to **43'** ft., From .... ft. to .... ft.

From .... ft. to .... ft., From .... ft. to .... ft.

GRAVEL PACK INTERVALS: From **17'** ft. to **43'** ft., From .... ft. to .... ft.

From .... ft. to .... ft., From .... ft. to .... ft.

6] GROUT MATERIAL:

1 Neat cement

2 Cement grout

3 Bentonite ☒

4 Other

Grout Intervals: From **0'** ft. to **17'** ft., From .... ft. to .... ft., From .... ft. to .... ft.

What is the nearest source of possible contamination:

1 Septic tank

2 Sewer lines

3 Watertight sewer lines 6 Seepage pit

4 Lateral lines

5 Cess pool

6 Seepage pit

7 Pit privy

8 Sewage lagoon

9 Feedyard

10 Livestock pens

11 Fuel storage

12 Fertilizer storage

13 Insecticide storage

☒ 14 Abandoned water well

15 Oil well/Gas well

16 Other (specify below)

Direction from well?

**North**

How many feet?

**75'**

FROM	TO	LITHOLOGIC LOG	FROM	TO	LITHOLOGIC LOG
0	15	brown clay			
15	20	broken limestone			
20	22	limestone & flint			
22	24	white shale			
24	26	gray shale			
26	31	layers of flint			
31	40	gray shale			
40	62	layers of limestone			

CONTRACTOR'S OR LANDOWNER'S CERTIFICATION: This water well was (1) constructed, (2) reconstructed, or (3) plugged under my jurisdiction and was completed on (mo/day/year) **2-24-1988** and this record is true to the best of my knowledge and belief. KansasWell Contractor's License No. **2346** This Water Well Record was completed on (mo/day/yr) **3-7-1988**the business name of **Blue Valley Drilling**by (signature) **Eric Smith**

INSTRUCTIONS: Use typewriter or ball point pen. PLEASE PRESS FIRMLY and PRINT clearly. Please fill in blanks, underline or circle the correct answers. Send top three copies to Kansas Department of Health and Environment, Bureau of Water Protection, Topeka, Kansas 66620-7320, Telephone: 913-862-9360. Send one to WATER WELL OWNER and retain one for your