


1 LOCATION OF WATER WELL: County: Morris Fraction: SW 1/4 SE 1/4 SE 1/4 Section Number: 32 Township Number: T 15 S Range Number: R 7 E/W

Distance and direction from nearest town or city street address of well if located within city?  
4 mile North of Wilsey

2 WATER WELL OWNER: Earl Robinson  
 RR#, St. Address, Box #: Rt 1  
 City, State, ZIP Code: Wilsey, ks 66873  
 Board of Agriculture, Division of Water Resources  
 Application Number:

3 LOCATE WELL'S LOCATION WITH AN "X" IN SECTION BOX:

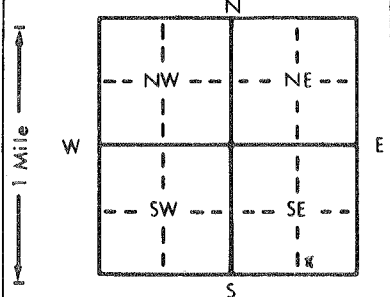

4 DEPTH OF COMPLETED WELL: 80 ft. ELEVATION: \_\_\_\_\_  
 Depth(s) Groundwater Encountered 1. 68 ft. 2. \_\_\_\_\_ ft. 3. \_\_\_\_\_ ft.

WELL'S STATIC WATER LEVEL: 30 ft. below land surface measured on mo/day/yr Apr 7-93  
 Pump test data: Well water was \_\_\_\_\_ ft. after \_\_\_\_\_ hours pumping \_\_\_\_\_ gpm  
 Est. Yield 20+ gpm: Well water was \_\_\_\_\_ ft. after \_\_\_\_\_ hours pumping \_\_\_\_\_ gpm  
 Bore Hole Diameter: 8 5/8 in. to 24 ft., and 6 7/8 in. to 80 ft.  
 WELL WATER TO BE USED AS:  
 1 Domestic     3 Feedlot     6 Oil field water supply     9 Dewatering     12 Other (Specify below)  
 2 Irrigation     4 Industrial     7 Lawn and garden only     10 Monitoring well  
 Was a chemical/bacteriological sample submitted to Department? Yes \_\_\_\_\_ No ; If yes, mo/day/yr sample was submitted \_\_\_\_\_  
 Water Well Disinfected?  Yes     No

5 TYPE OF BLANK CASING USED:  
 1 Steel     3 RMP (SR)     5 Wrought iron     8 Concrete tile    CASING JOINTS:  Glued     Clamped  
 2 PVC     4 ABS     6 Asbestos-Cement     9 Other (specify below)     Welded  
 \_\_\_\_\_     7 Fiberglass     \_\_\_\_\_     Threaded

Blank casing diameter: 5 in. to 30 ft., Dia \_\_\_\_\_ in. to \_\_\_\_\_ ft., Dia \_\_\_\_\_ in. to \_\_\_\_\_ ft.  
 Casing height above land surface: 16 in., weight \_\_\_\_\_ lbs./ft. Wall thickness or gauge No. SDR-26

TYPE OF SCREEN OR PERFORATION MATERIAL:  
 1 Steel     3 Stainless steel     5 Fiberglass     7 PVC     10 Asbestos-cement  
 2 Brass     4 Galvanized steel     6 Concrete tile     8 RMP (SR)     11 Other (specify) \_\_\_\_\_  
 \_\_\_\_\_     \_\_\_\_\_     \_\_\_\_\_     9 ABS     12 None used (open hole)

SCREEN OR PERFORATION OPENINGS ARE:  
 1 Continuous slot     3 Mill slot     5 Gauzed wrapped     8 Saw cut     11 None (open hole)  
 2 Louvered shutter     4 Key punched     6 Wire wrapped     9 Drilled holes  
 \_\_\_\_\_     \_\_\_\_\_     \_\_\_\_\_     10 Other (specify) \_\_\_\_\_

SCREEN-PERFORATED INTERVALS: From 30 ft. to 80 ft., From \_\_\_\_\_ ft. to \_\_\_\_\_ ft.  
 From \_\_\_\_\_ ft. to \_\_\_\_\_ ft., From \_\_\_\_\_ ft. to \_\_\_\_\_ ft.  
 GRAVEL PACK INTERVALS: From NONE ft. to \_\_\_\_\_ ft., From \_\_\_\_\_ ft. to \_\_\_\_\_ ft.  
 From \_\_\_\_\_ ft. to \_\_\_\_\_ ft., From \_\_\_\_\_ ft. to \_\_\_\_\_ ft.

6 GROUT MATERIAL:  1 Neat cement     2 Cement grout     3 Bentonite     4 Other \_\_\_\_\_  
 Grout Intervals: From 3 ft. to 24 ft., From \_\_\_\_\_ ft. to \_\_\_\_\_ ft., From \_\_\_\_\_ ft. to \_\_\_\_\_ ft.

What is the nearest source of possible contamination:  
 1 Septic tank     4 Lateral lines     7 Pit privy     10 Livestock pens     14 Abandoned water well  
 2 Sewer lines     5 Cess pool     8 Sewage lagoon     11 Fuel storage     15 Oil well/Gas well  
 3 Watertight sewer lines     6 Seepage pit     9 Feedyard     12 Fertilizer storage     16 Other (specify below) Milg. Field Cran.  
 \_\_\_\_\_     \_\_\_\_\_     \_\_\_\_\_     13 Insecticide storage     \_\_\_\_\_

Direction from well? In Field How many feet? In Field

FROM	TO	LITHOLOGIC LOG	FROM	TO	PLUGGING INTERVALS
0	2	Topsoil BIK	80	T.D	Red Rock
2	7	Clay Brn			
7	9	LIME-Frac TAN			
9	10	Shale TAN			
10	12	LIME TAN			
12	14	Shale TAN			
14	26	LIME TAN			
26	28	Shale TAN			
28	58	LIME - Almost White			
58	59	Shale - Libe			
59	67	LIME - white / Blue Flint			
67	76	Crevice or frac LIME			
76	74	LIME - Libe / Blue Flint			
74	76	Shale Gray			
76	80	Shale Green			

7 CONTRACTOR'S OR LANDOWNER'S CERTIFICATION: This water well was  (1) constructed, (2) reconstructed, or (3) plugged under my jurisdiction and was completed on (mo/day/year) Apr 7-93 and this record is true to the best of my knowledge and belief. Kansas Water Well Contractor's License No. 218 This Water Well Record was completed on (mo/day/yr) May 2-93 under the business name of Zinn Water Well Drlg by (signature) Joseph A. Zinn