


1 LOCATION OF WATER WELL: Fraction NE 1/4 NW 1/4 NE 1/4 Section Number W4 LOT 2 Township Number 15 Range Number 8
 County: MORRIS W4 LOT 2 T15W1N5E R 8 (EW)

Distance and direction from nearest town or city street address of well if located within city?
ALTA VISTA KAN 6 1/2 S 1/2 E

2 WATER WELL OWNER: LESTER CASTERLINE AND ELDO CASTERLINE
 RR#, St. Address, Box #: RD 2 Box 28 Board of Agriculture, Division of Water Resource
 City, State, ZIP Code: ALTA VISTA KAN 66834 Application Number: 10 ACKRE TRACT

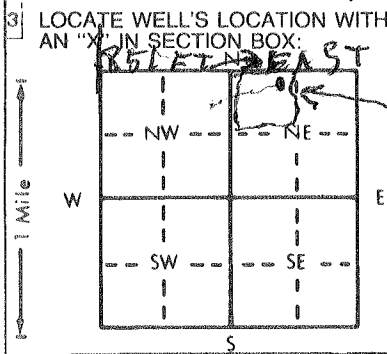

4 DEPTH OF COMPLETED WELL. DONT KNOW ELEVATION:
 Depth(s) Groundwater Encountered 1. 6 FT 2. 3. WELL FILLED WITH ROCK
 WELL'S STATIC WATER LEVEL DONT KNOW Below land surface measured on mo/day/yr DEC 12 1992
 Pump test data: Well water was ft. after hours pumping gpm
 Est. Yield gpm: Well water was ft. after hours pumping gpm
 Bore Hole Diameter: 9 in. to ft., and in. to ft.
 WELL WATER TO BE USED AS: 5 Public water supply 8 Air conditioning 11 Injection well
 1 Domestic 3 Feedlot 6 Oil field water supply 9 Dewatering 12 Other (Specify below)
 2 Irrigation 4 Industrial 7 Lawn and garden only 10 Monitoring well
 Was a chemical/bacteriological sample submitted to Department? Yes.....No.....; If yes, mo/day/yr sample was submitted
 Water Well Disinfected? Yes No

5 TYPE OF BLANK CASING USED: 5 Wrought iron 8 Concrete tile CASING JOINTS: Glued Clamped
 1 Steel 3 RMP (SR) 6 Asbestos-Cement 9 Other (specify below) Welded
 2 PVC 4 ABS 7 Fiberglass Threaded
 Blank casing diameter 9 IN in. to ft., Dia in. to ft., Dia in. to ft.
 Casing height above land surface TARE OUT in., weight lbs./ft. Wall thickness or gauge No.
 TYPE OF SCREEN OR PERFORATION MATERIAL: 7 PVC 10 Asbestos-cement
 1 Steel 3 Stainless steel 5 Fiberglass N/A 8 RMP (SR) 11 Other (specify)
 2 Brass 4 Galvanized steel 6 Concrete tile 9 ABS 12 None used (open hole)
 SCREEN OR PERFORATION OPENINGS ARE: 5 Gauzed wrapped 8 Saw cut 11 None (open hole)
 1 Continuous slot 3 Mill slot N/A 6 Wire wrapped 9 Drilled holes
 2 Louvered shutter 4 Key punched 7 Torch cut 10 Other (specify)
 SCREEN-PERFORATED INTERVALS: From ft. to ft., From ft. to ft.
 From N/A ft. to ft., From ft. to ft.
 GRAVEL PACK INTERVALS: From ft. to ft., From ft. to ft.
 From ft. to N/A ft., From ft. to ft.

6 GROUT MATERIAL: 1 Neat cement 2 Cement grout 3 Bentonite 4 Other
 Grout Intervals: From ft. to ft., From ft. to ft., From ft. to ft.
 What is the nearest source of possible contamination: NONE 10 Livestock pens 14 Abandoned water well
 1 Septic tank 4 Lateral lines 7 Pit privy 11 Fuel storage 15 Oil well/Gas well
 2 Sewer lines 5 Cess pool 8 Sewage lagoon 12 Fertilizer storage 16 Other (specify below)
 3 Watertight sewer lines 6 Seepage pit 9 Feedyard 13 Insecticide storage
 Direction from well? How many feet?

FROM	TO	LITHOLOGIC LOG	FROM	TO	PLUGGING INTERVALS
		<u>WELL FILLED TO TOP WITH ROCK</u>			<u>DUG DOWN WITH BACKHOLE</u>
		<u>TO SOLID ROCK 3 FT WITH 1 FT BENTONITE IN WELL</u>			<u>3 FT WIDE 4 FT LONG 16 IN DEE</u>
		<u>DEEP 6 IN CEMENT CONCRETE</u>			
		<u>32 IN DIRT ON TOP NO CONTAMINATION</u>			
		<u>WILL SMOOTH DOWN BETTER WHEN SOIL IS DRYER</u>			
		<u>85 FT FROM 1/2 MILE LINE EAST</u>			<u>28 FT FROM CENTER</u>
		<u>OF ROAD</u>			
		<u>MAILED DEC 14 1992</u>			

7 CONTRACTOR'S OR LANDOWNER'S CERTIFICATION: This water well was (1) constructed, (2) reconstructed, or (3) plugged under my jurisdiction and was completed on (mo/day/year) DEC 12 1992 and this record is true to the best of my knowledge and belief. Kansas Water Well Contractor's License No. 1500 This Water Well Record was completed on (mo/day/yr) DEC 13 1992 under the business name of by (signature) LESTER CASTERLINE